


T 1 S, R 3 W, W.M.

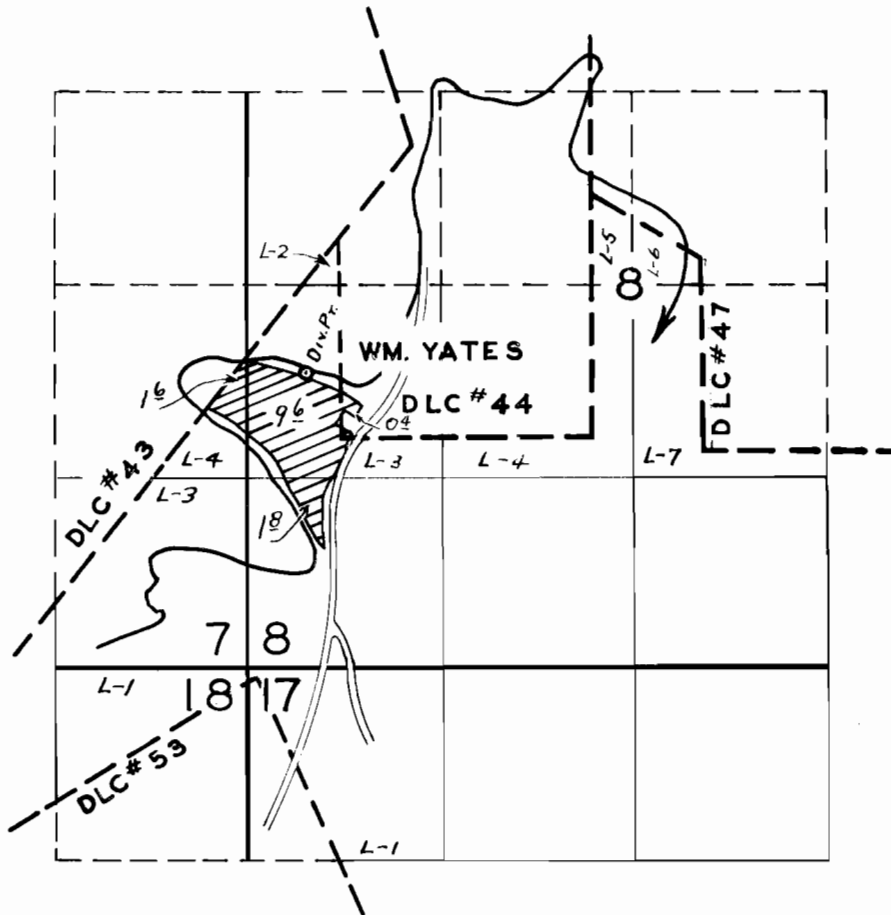

FINAL PROOF SURVEY

UNDER

Application No. 27319 Permit No. 21481

IN NAME OF

W.E. LIMPUS

Surveyed 5-2 1956, by R.D. BEST