


T. 5 S. R. 1 W. W. M.

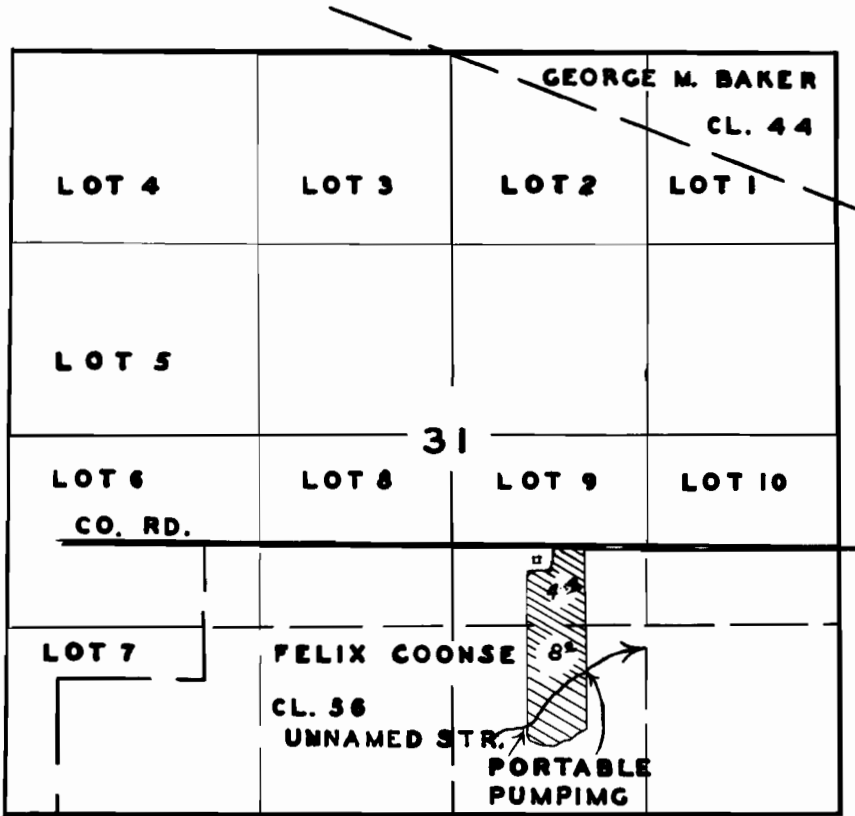

**FINAL PROOF SURVEY**  
UNDER

Application No. 27361      Permit No. 21542

IN NAME OF

FRANK PRANTL

Surveyed MAY 31, 1956, by C. O. BARTELS