


T. 3 S. R. 1 W. W. M.

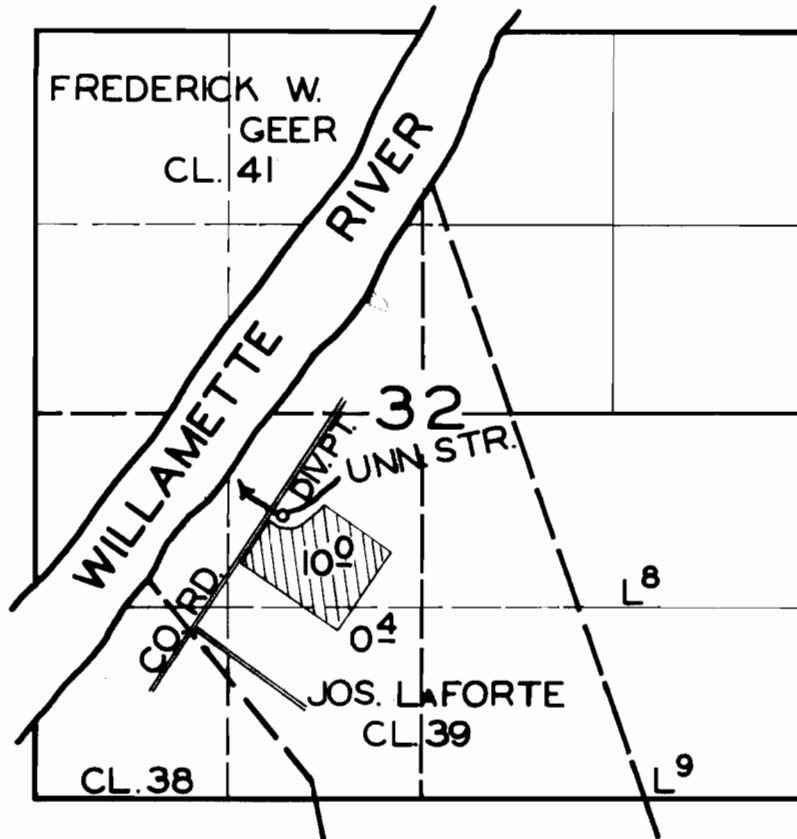

**FINAL PROOF SURVEY**

UNDER

Application No. 26026 Permit No. 21573

IN NAME OF

**RAY MARTIN**

Surveyed 27 SEPT. 1956, by M. BISH