


T1N, R4W, W.M.

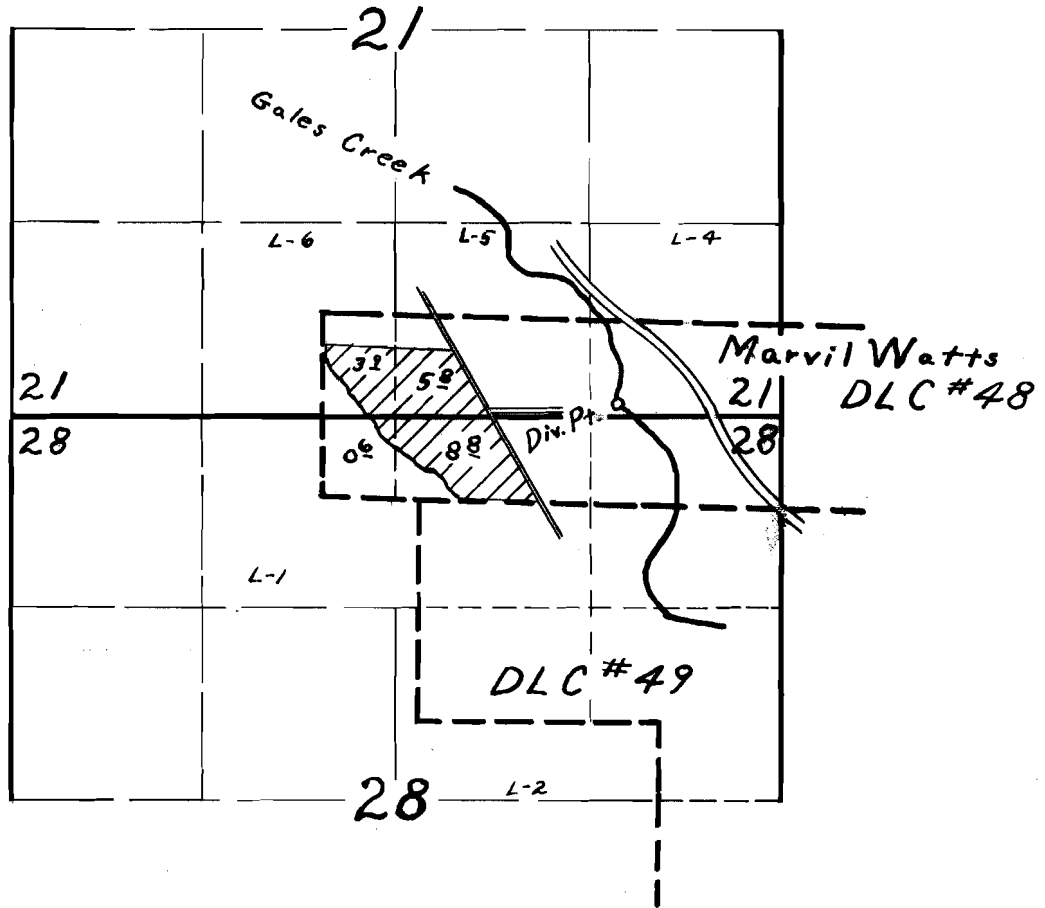

FINAL PROOF SURVEY
UNDER

Application No. 27712 Permit No. 21813

IN NAME OF

Estate of Fred Oberg

Surveyed 4-10 1956, by R.D. Best