


T1N, R4W, WM.

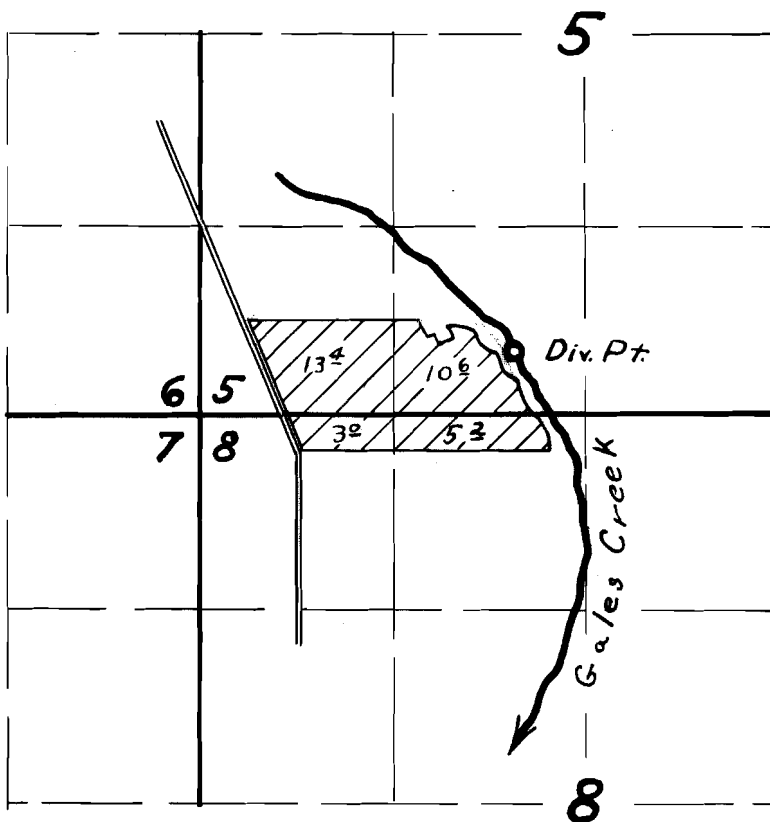

FINAL PROOF SURVEY

UNDER

Application No. 27774 Permit No. 21865

IN NAME OF

Charles J. James

Surveyed 4-12 1956, by R.D. Best