


T. 4 S. R. 4 W. W. M.

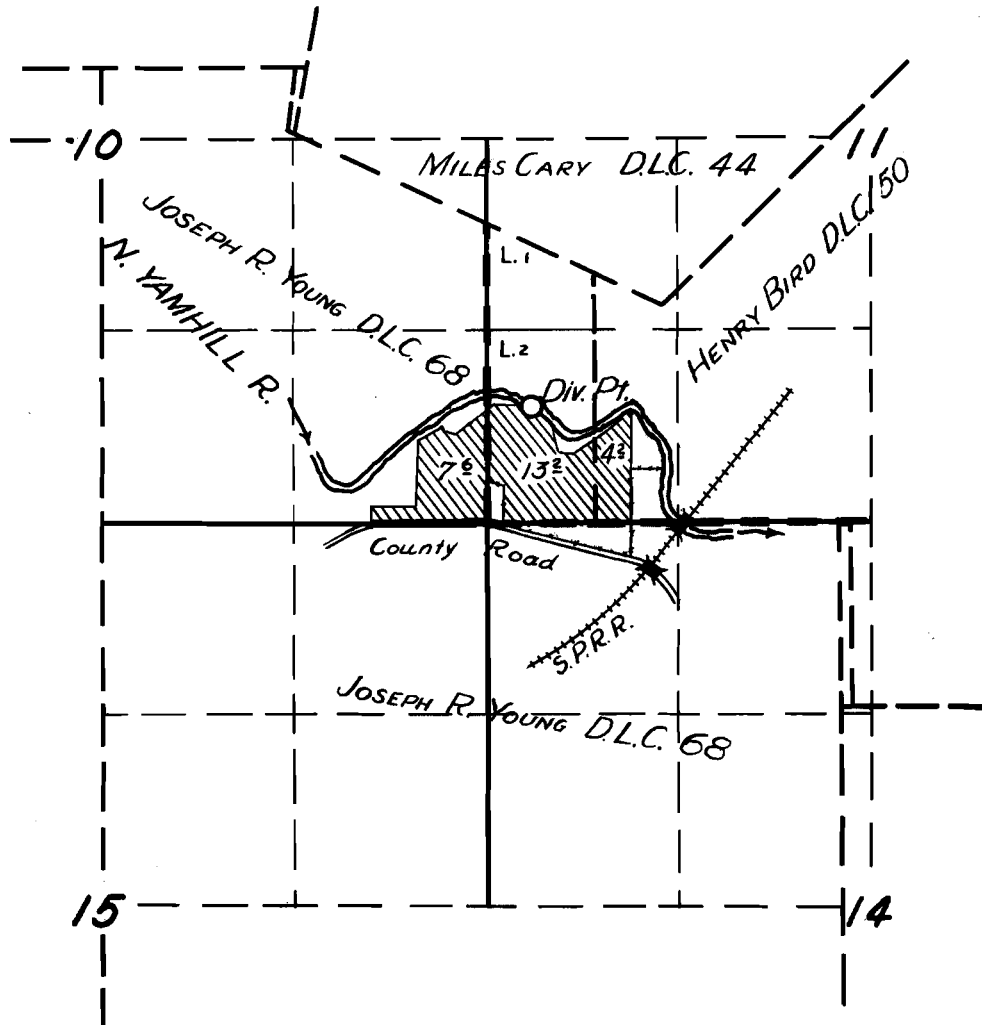

**FINAL PROOF SURVEY**

UNDER

Application No. 27821 Permit No. 21884

IN NAME OF

**B. E. CABE & SON**

Surveyed 21 Sep. 1955, by R. A. Whitby

DFQ-3D-139