


T1N, R4W, WM

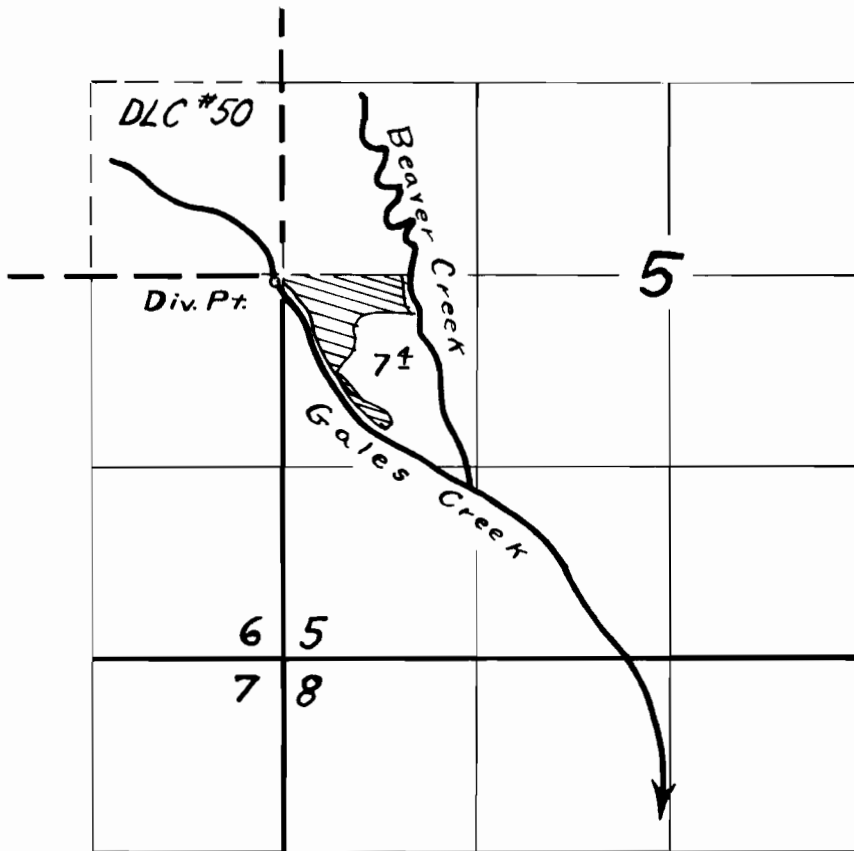

FINAL PROOF SURVEY

UNDER

Application No. 28003 Permit No. 22038

IN NAME OF

CHARLES NEWTON JAMES

Surveyed 4-12 1956, by R.D. BEST