


T1S. R3 & 4 W. WM

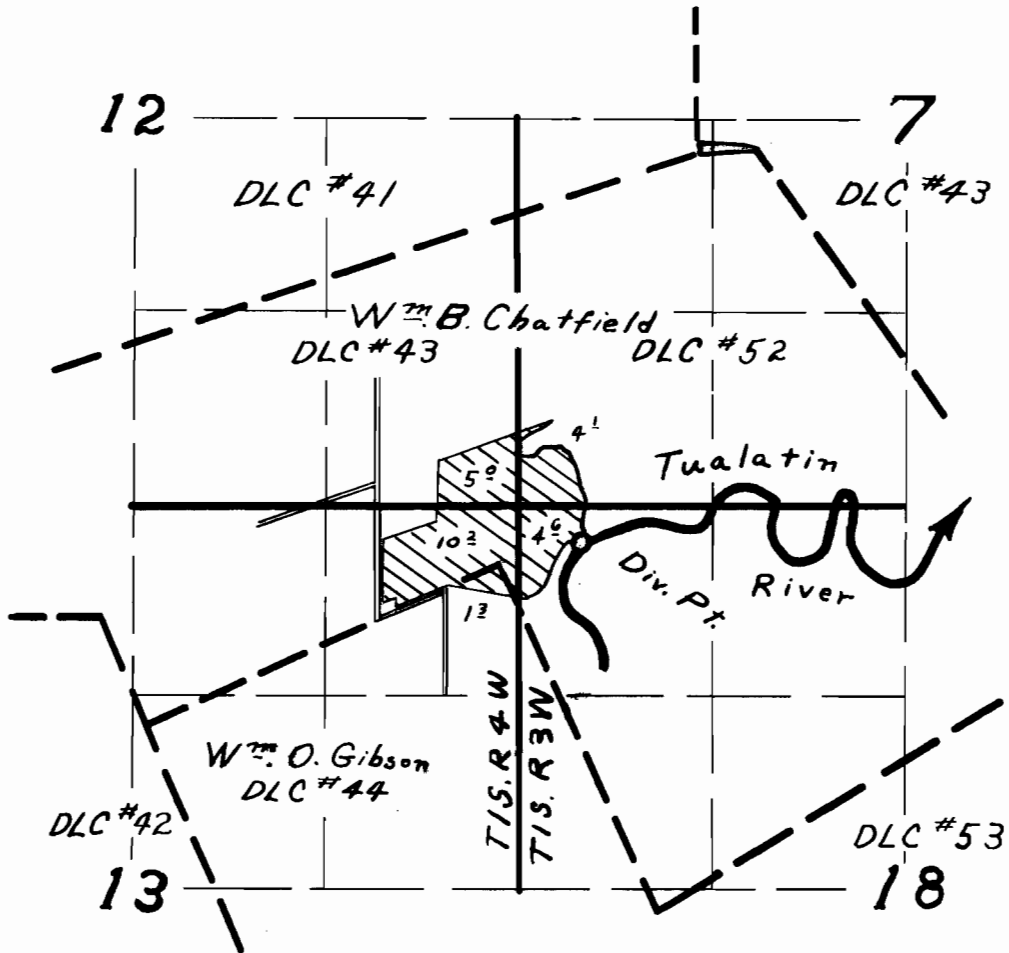

FINAL PROOF SURVEY

UNDER

Application No. 28005 Permit No. 22040

IN NAME OF

Frank Vanaken

Surveyed 5-2 1956, by R.D. Best