


T. 5 S. R. 7 W. W.M.

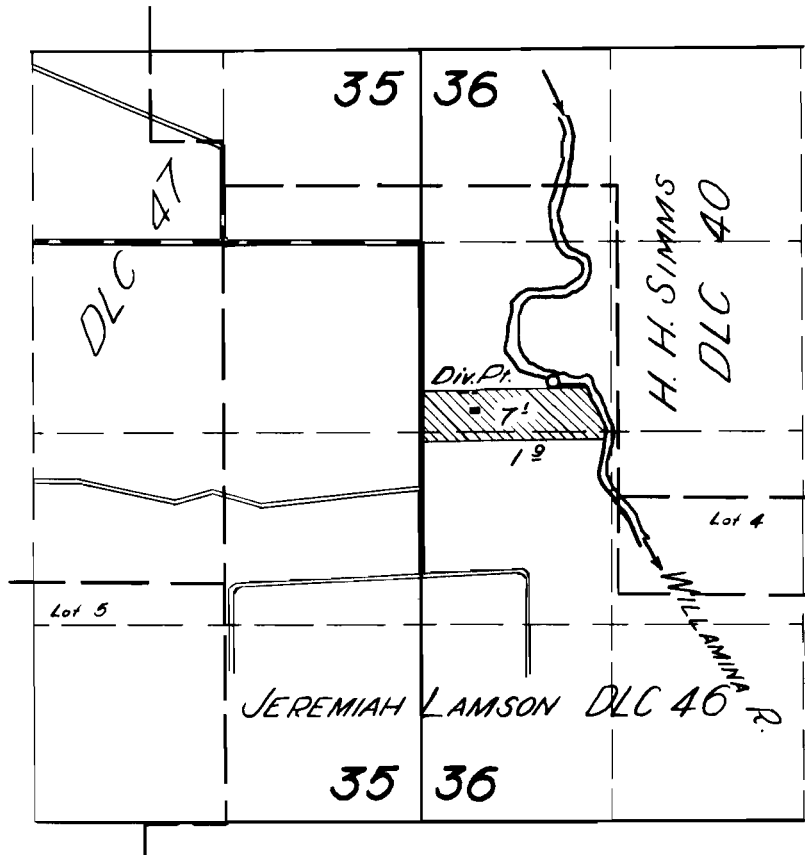

FINAL PROOF SURVEY

UNDER

Application No. 28008 Permit No. 22043

IN NAME OF

JOHN HAAKE

Surveyed 15 Mar 1956, by C. H. Shelby