


T.5S. R.3W.WM.

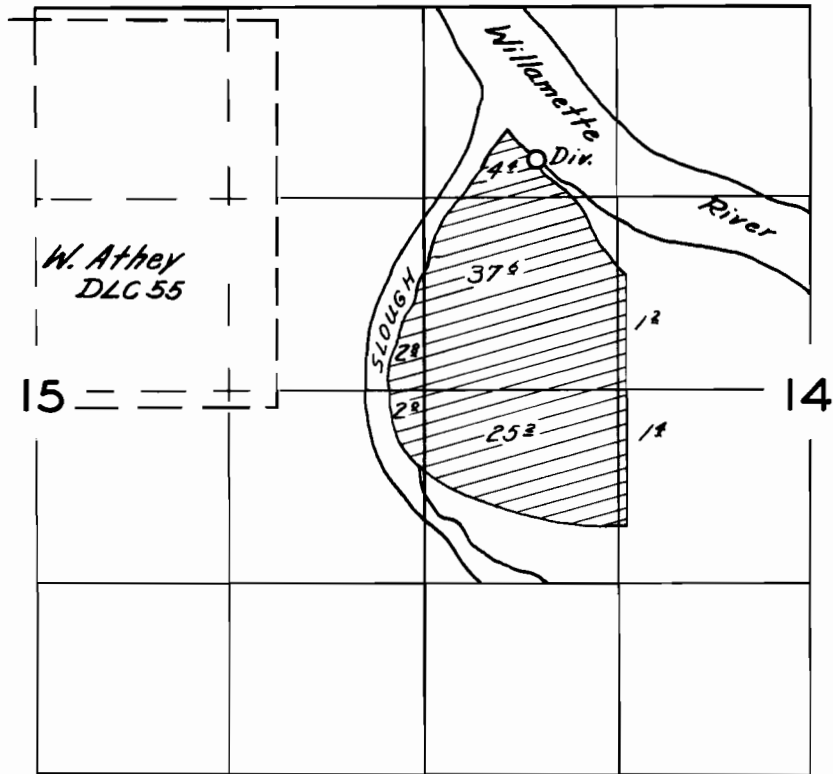

FINAL PROOF SURVEY

UNDER

Application No. *28106*... Permit No. *22125*...

IN NAME OF

W.O. WILEY

Surveyed *May 26*, 1955, by *T. Jones*.....