


T. 14 S. R. 9 W. W.M.

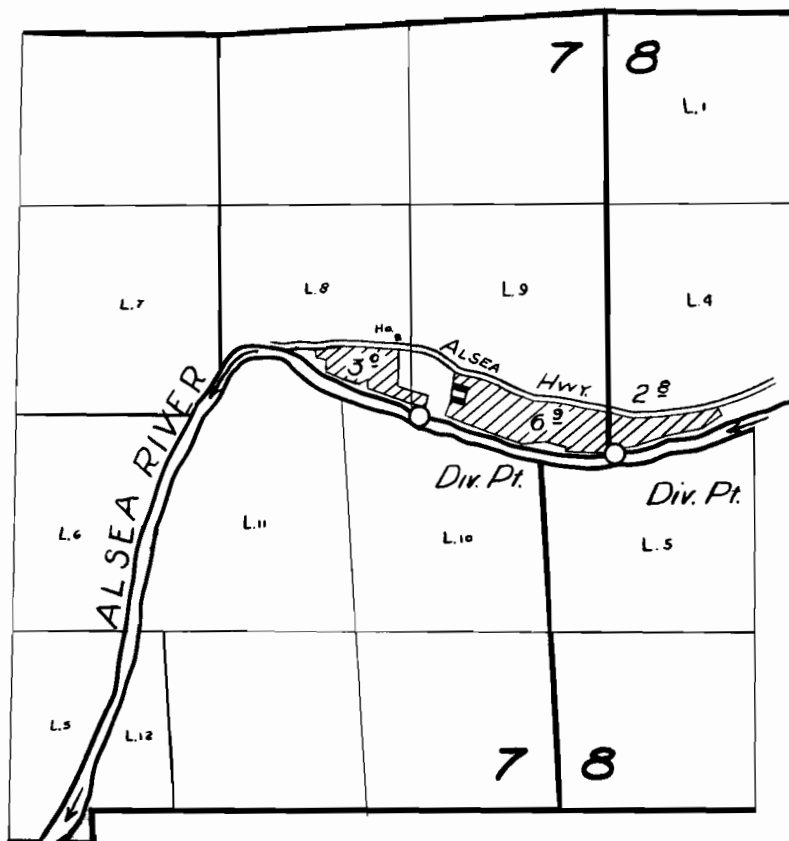

FINAL PROOF SURVEY  
UNDER

Application No. 28211 Permit No. 22198  
IN NAME OF

**LAURAN J. STOW**

Surveyed 28 June 1955, by T. JONES