


T. 5 S. R. 7 W. W. M.

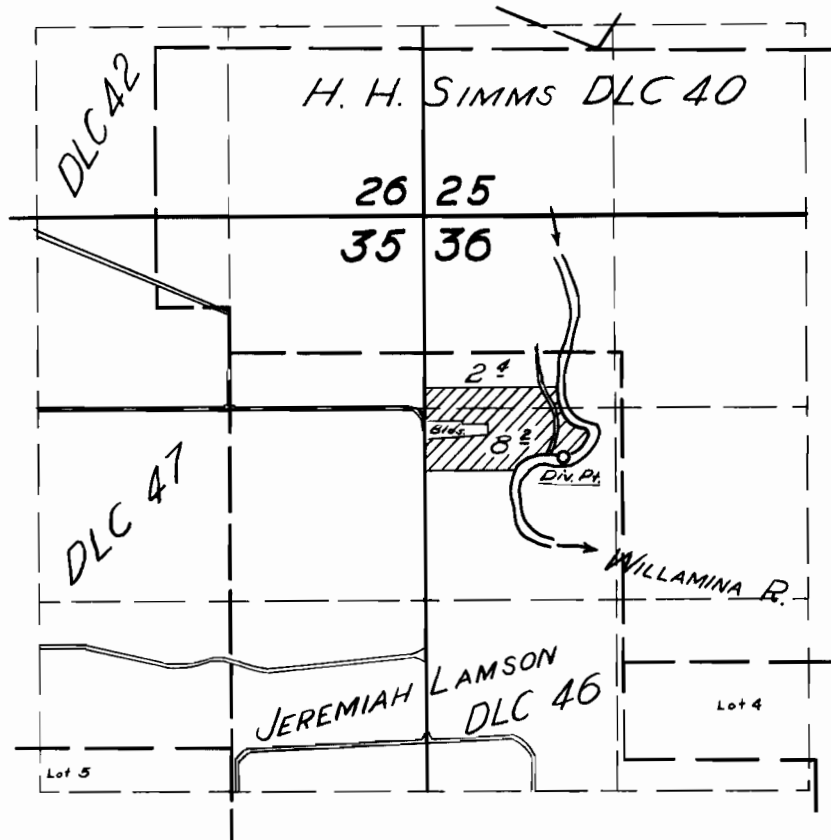

FINAL PROOF SURVEY
UNDER

Application No. 28411 Permit No. 22269
IN NAME OF

GEORGE MERLE NEWBILL

Surveyed 9 Mar. 1956, by C. H. [Signature]