


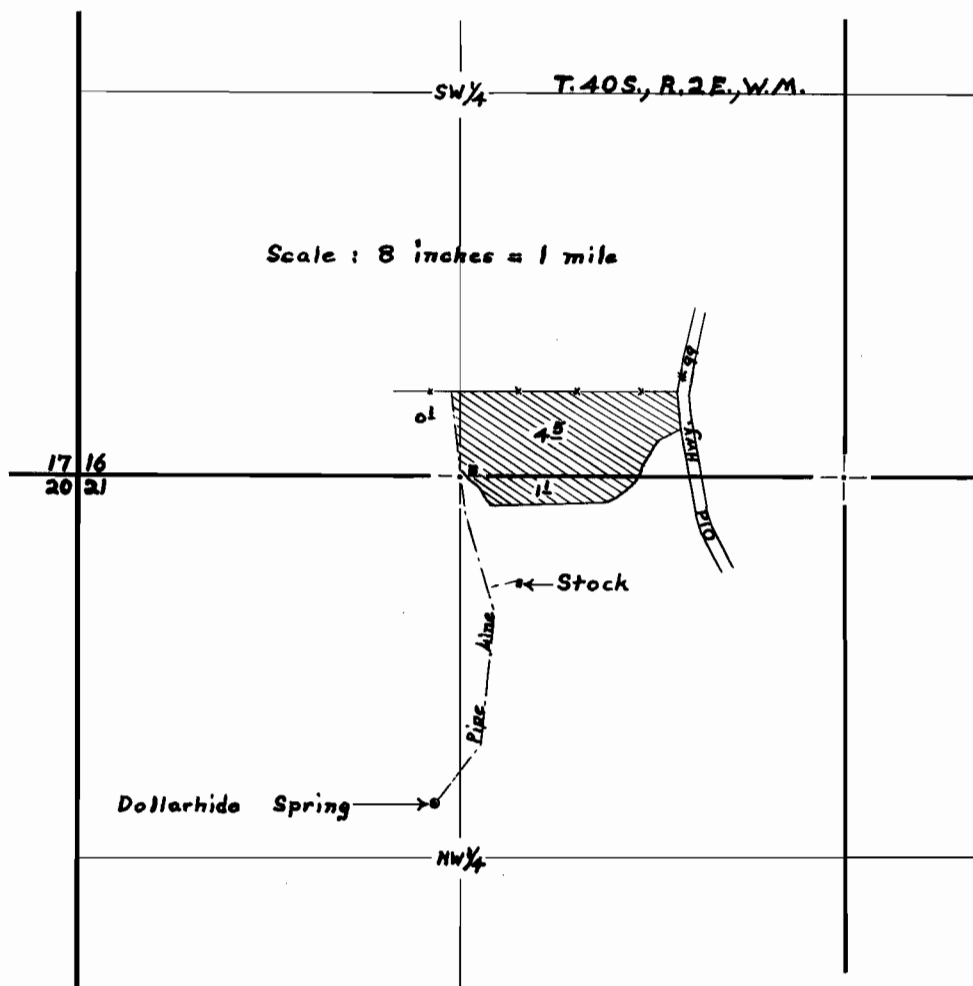

FINAL PROOF SURVEY UNDER

Application No. 28420..... Permit No. 22274.....
IN NAME OF

Dorothy D. Presley

Surveyed Nov. 15 1956, by D.C. Hendrix, W.M.