


T.29S.R.5W.W.M.

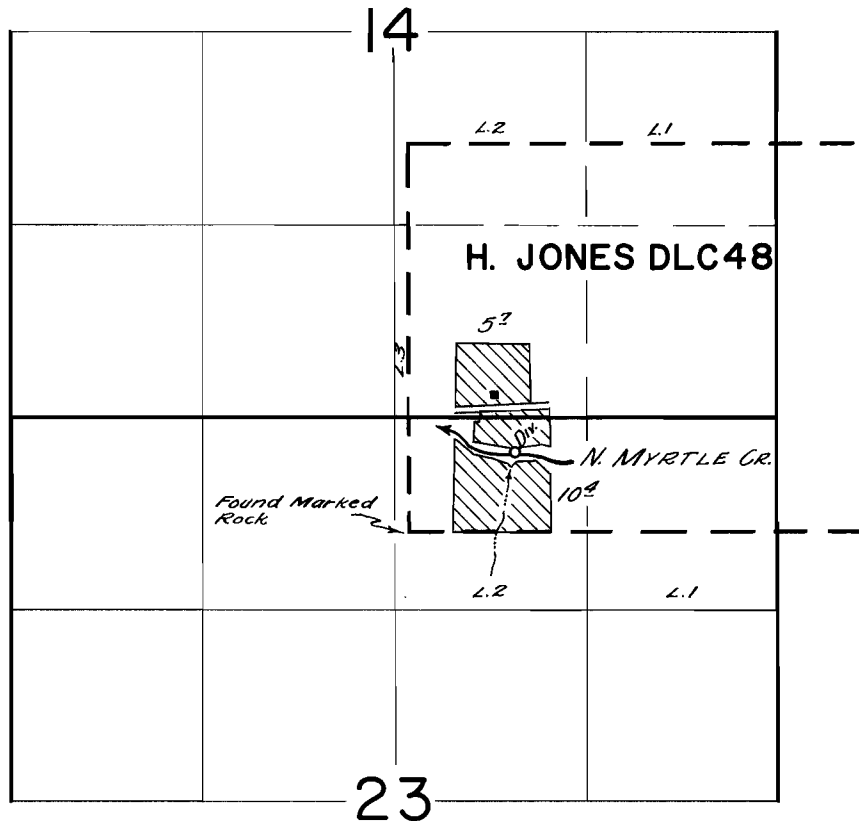

**FINAL PROOF SURVEY**  
UNDER

Application No. \_\_\_\_\_ Permit No. \_\_\_\_\_  
IN NAME OF

\_\_\_\_\_ **John Wallin** \_\_\_\_\_

Surveyed \_\_\_\_\_ 19\_\_\_\_, by \_\_\_\_\_