


T1S, R3E4W, WM.

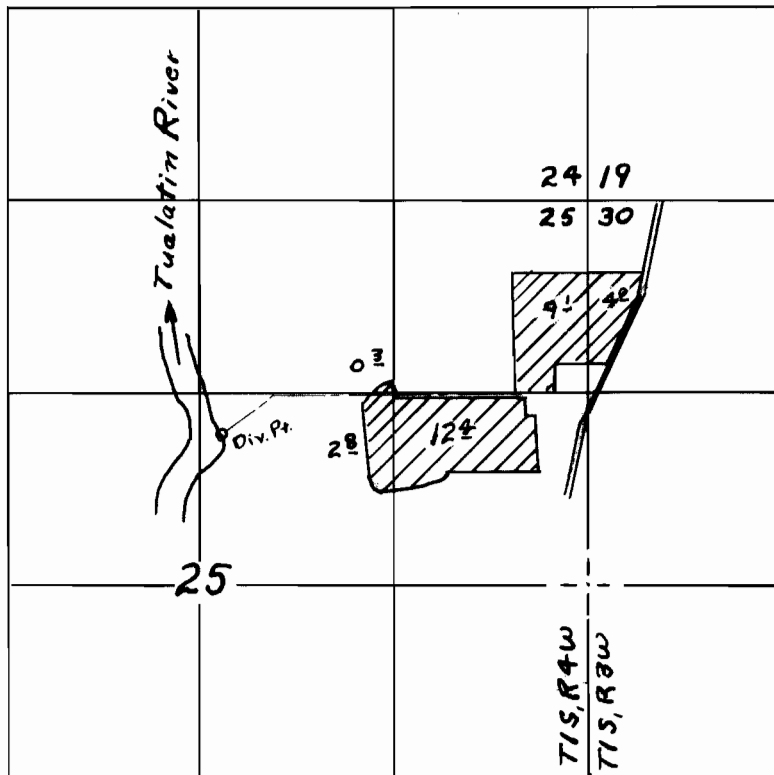

FINAL PROOF SURVEY

UNDER

Application No. 28121 Permit No. 22432

IN NAME OF

John Sundqvist

Surveyed 4-26 1956, by R.D. Best