


T.3S. R. 3E.W.M.

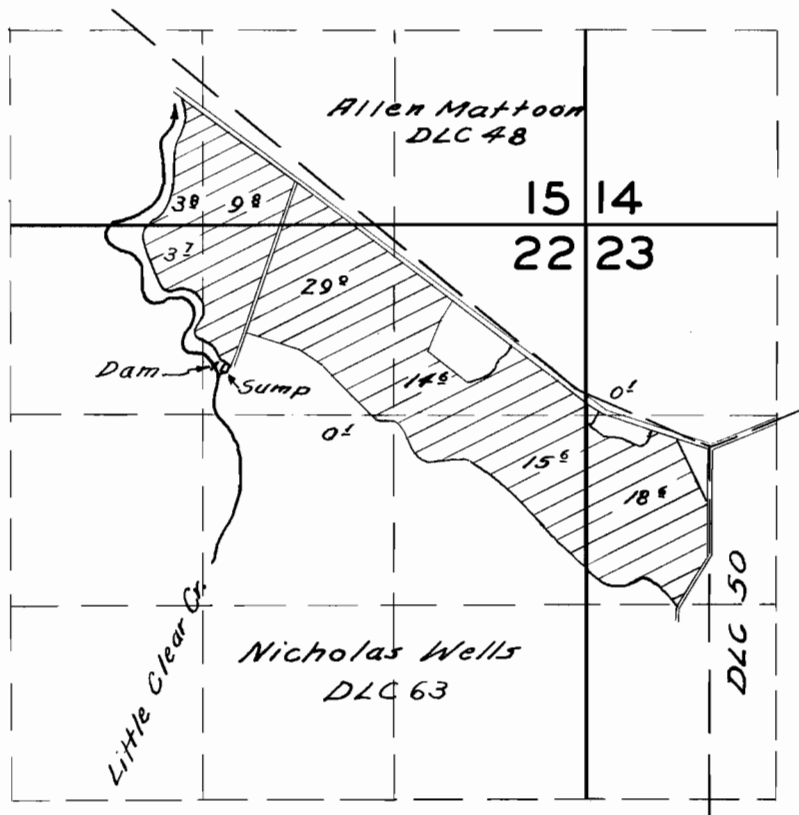

FINAL PROOF SURVEY

UNDER

Application No. 2817A Permit No. 22439

IN NAME OF

FRANK COMPANY

Surveyed Sept 27 1956, by Ch. Bartels