


T.4 S. R. 4 W. W.M.

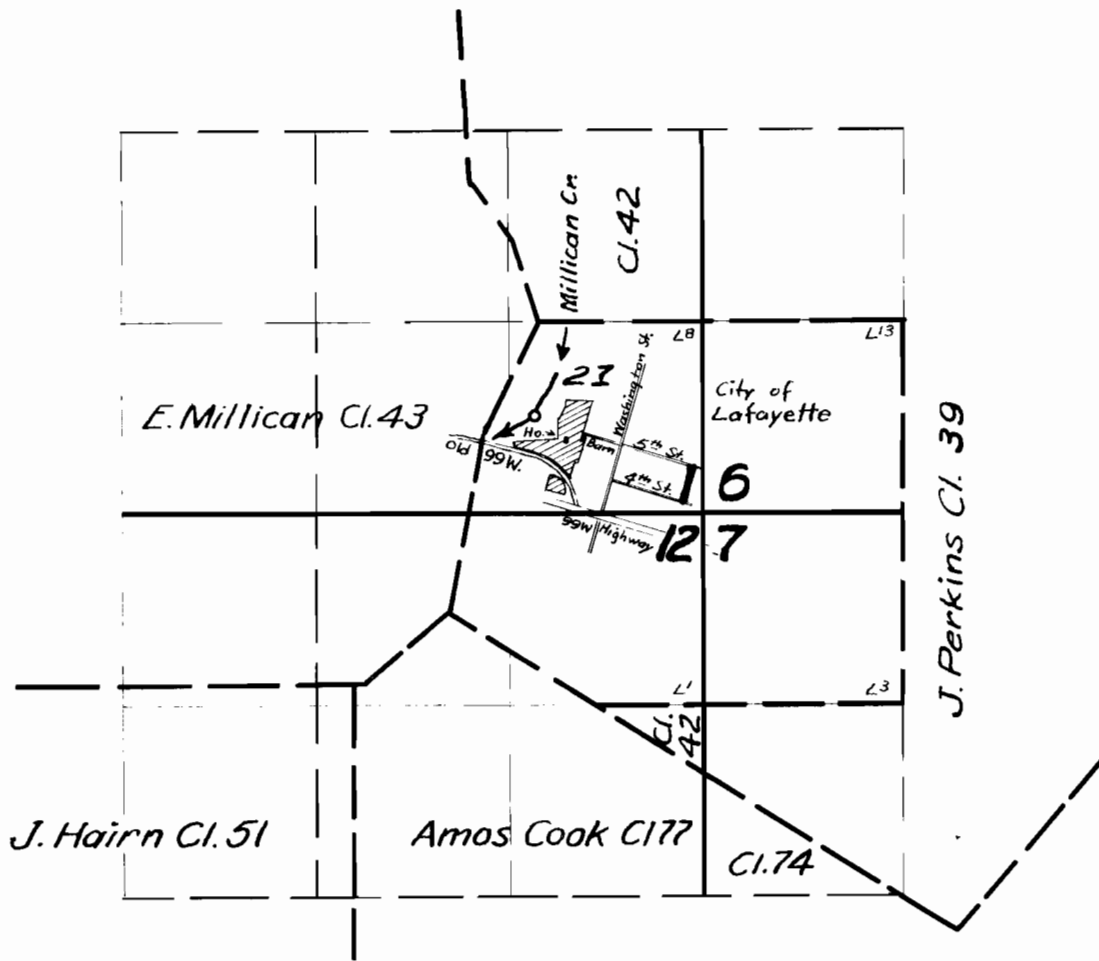

FINAL PROOF SURVEY
UNDER

Application No. **28649** Permit No. **22566**
IN NAME OF

Thomas Keffer

Surveyed *Mar 6* 1956, by *Tm. Bish...*