


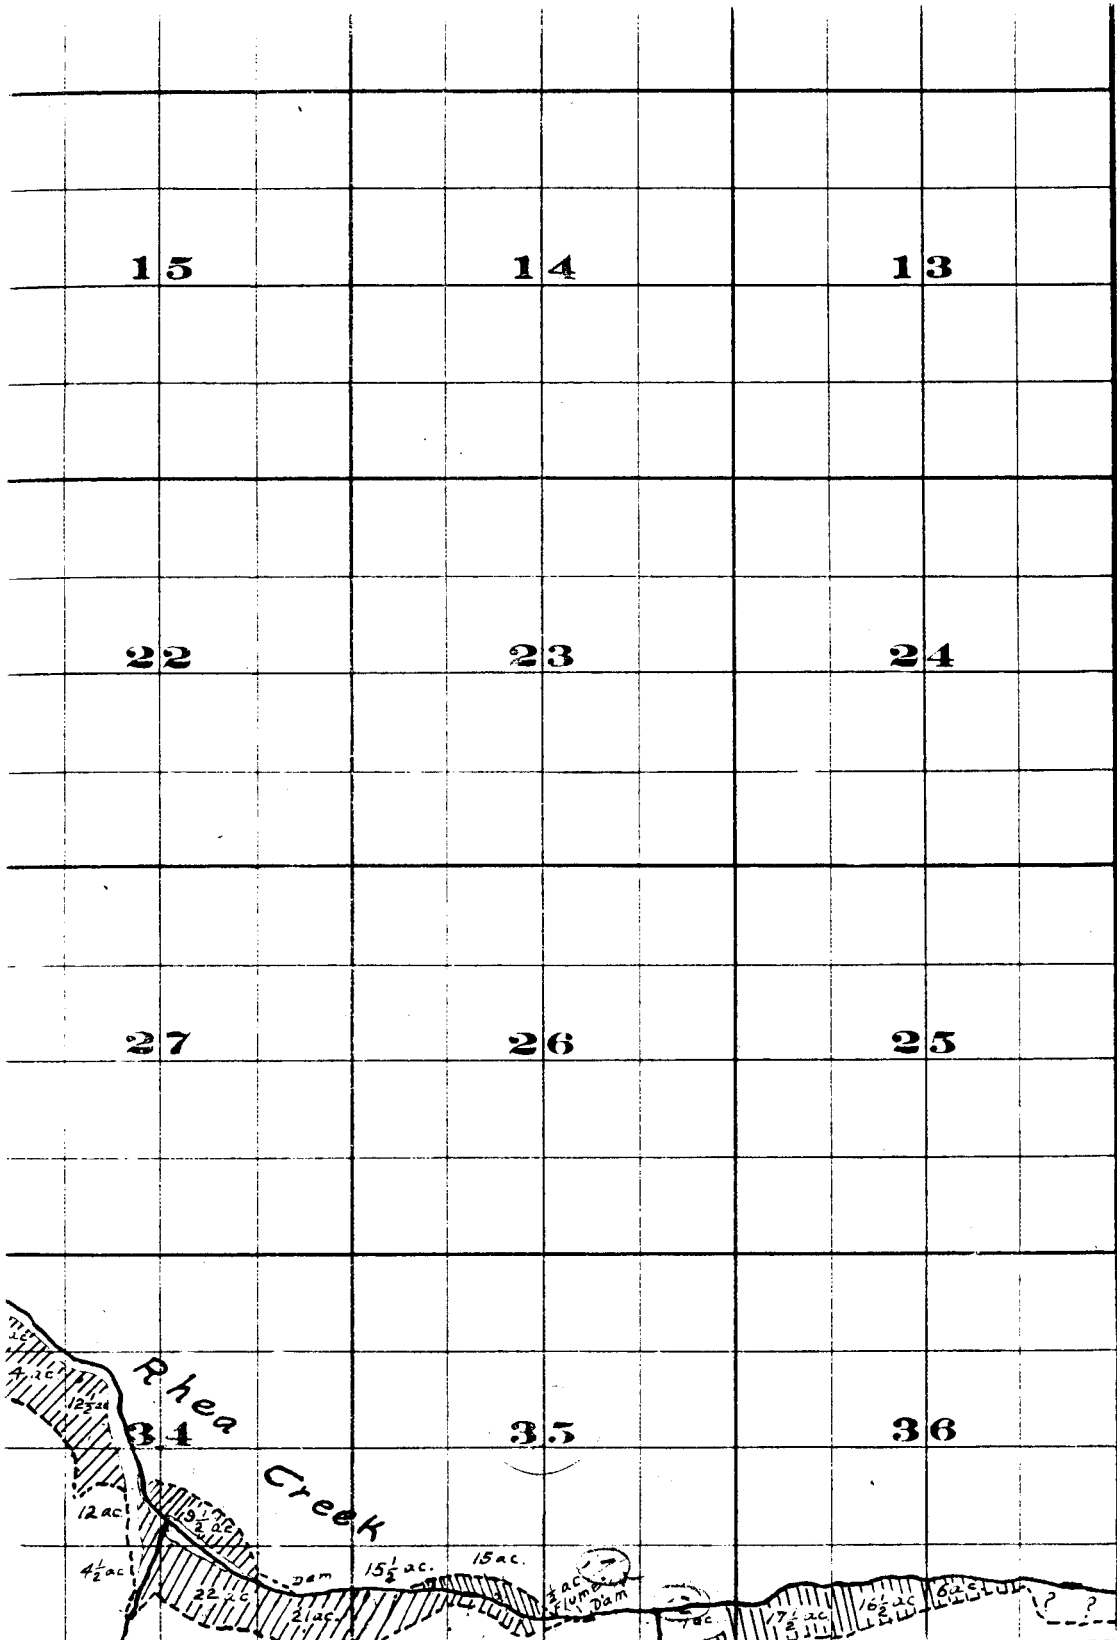


July 1909

July 1909


Willow Creek Adjudication

3 S. 25 E.  
Part 4 S. 25 E.

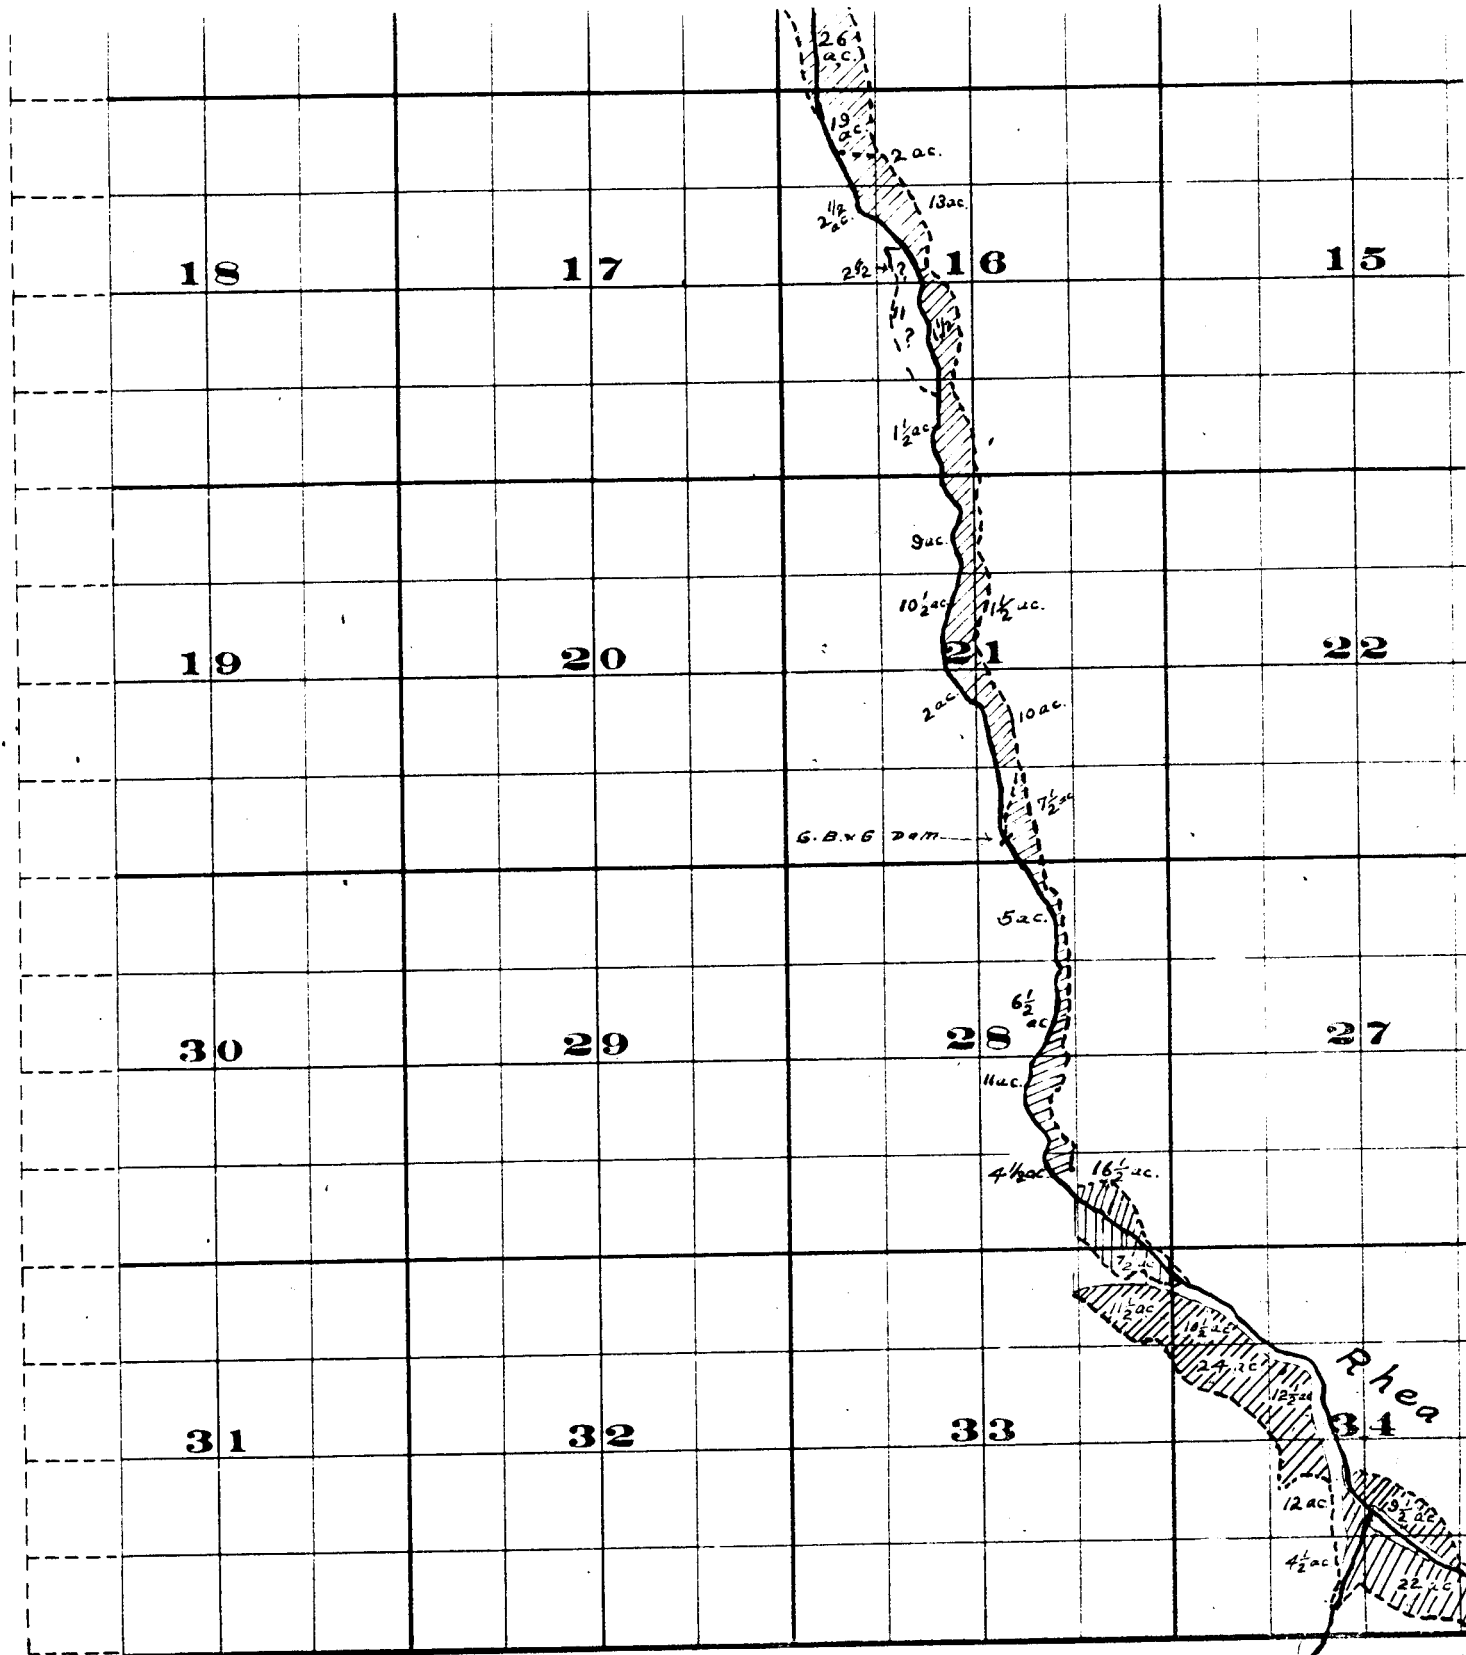

S. 28~North Surveyed by R.D.Cooper July  
 S. 33~South Surveyed by H.K.Donnelly July  
 John H Lewis - State Engineer  
 Examined July 14, 1909.

# Township 3 S.

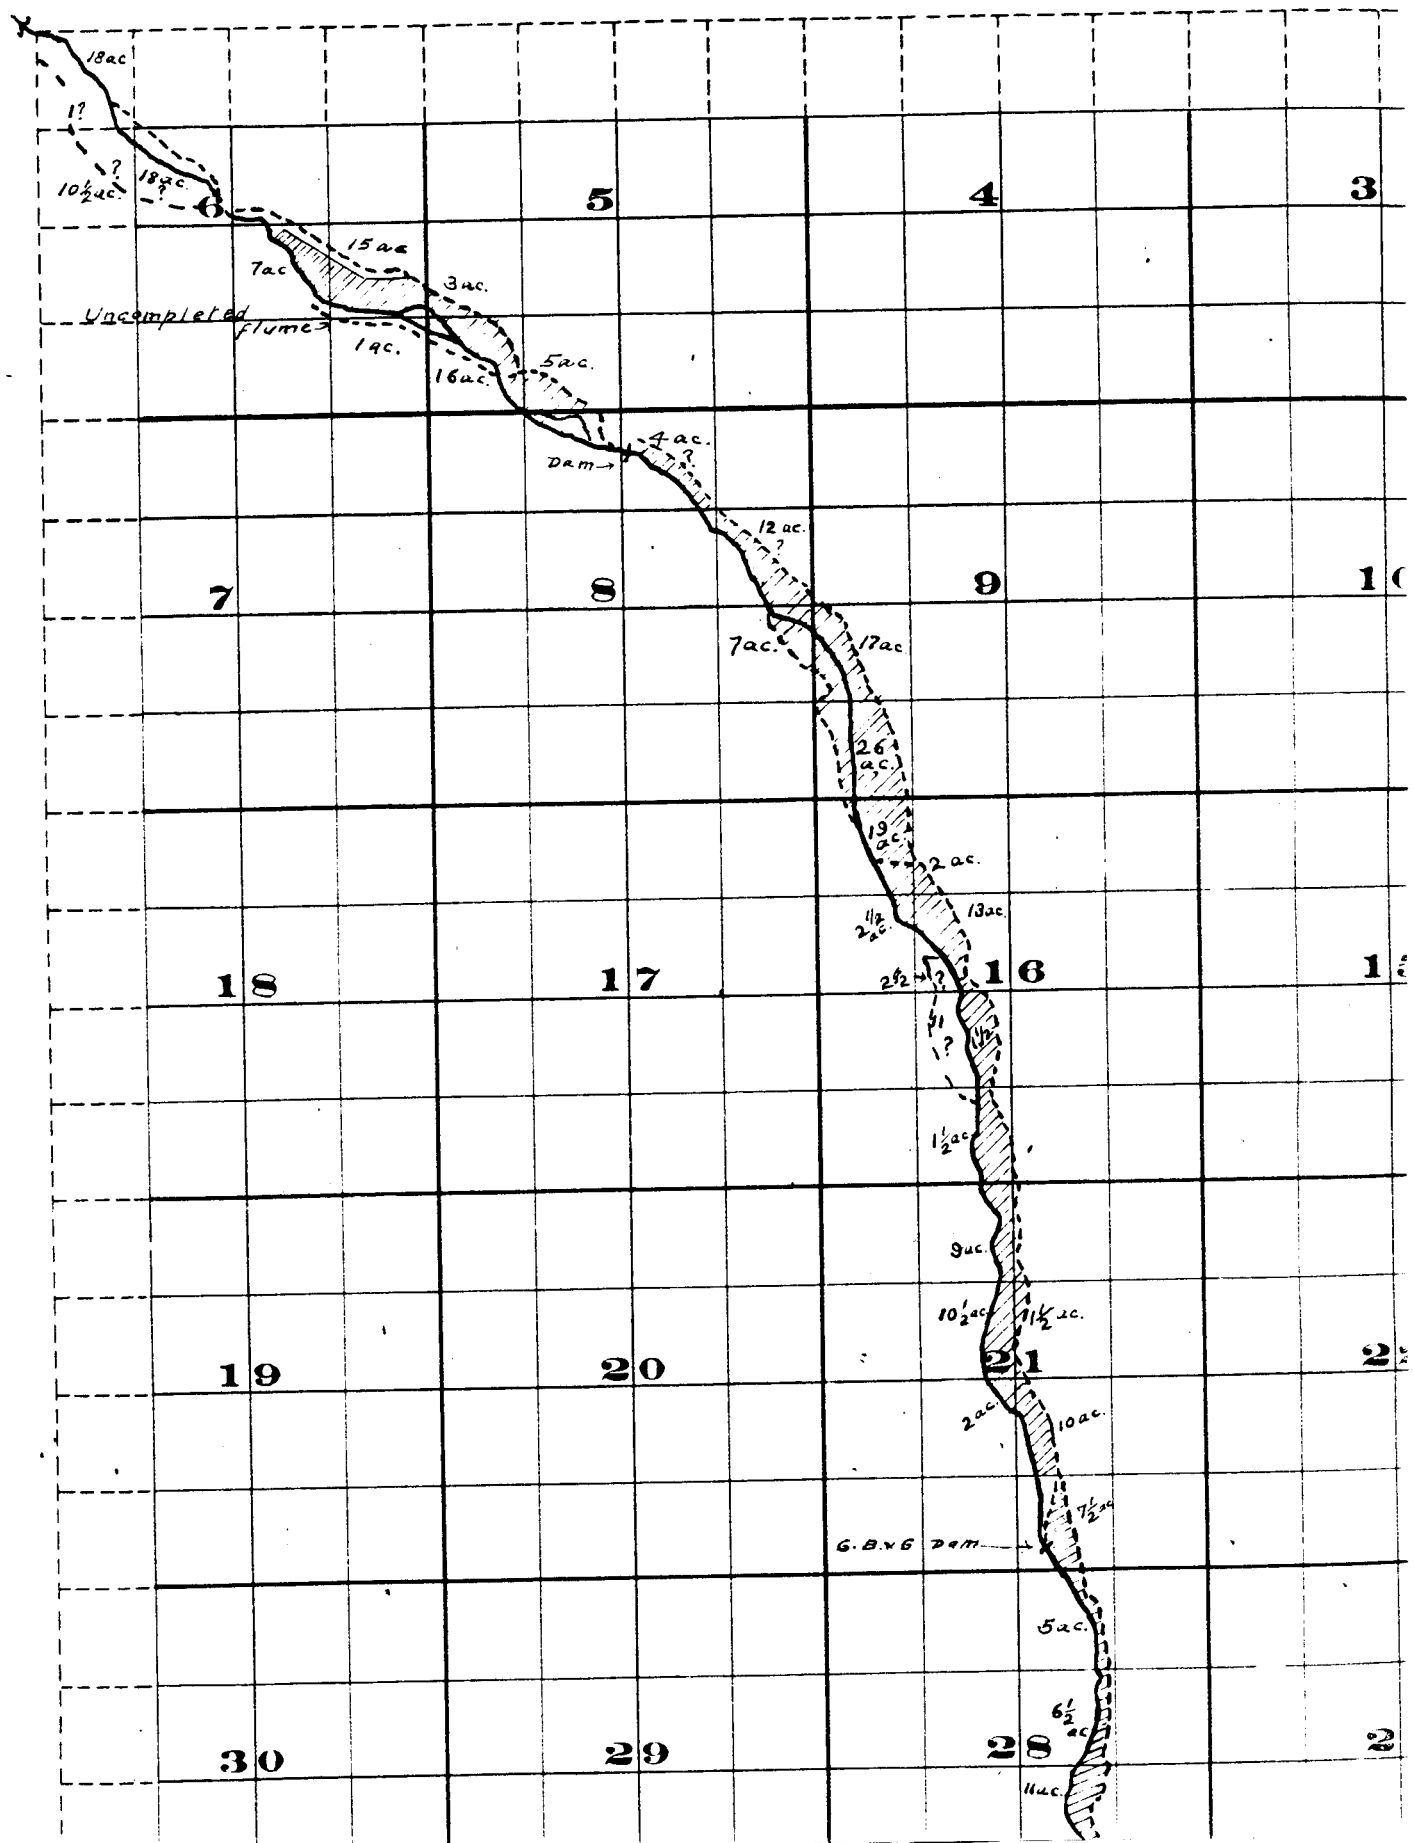

Range 25 E.W.M.

