


T23S, R9W.

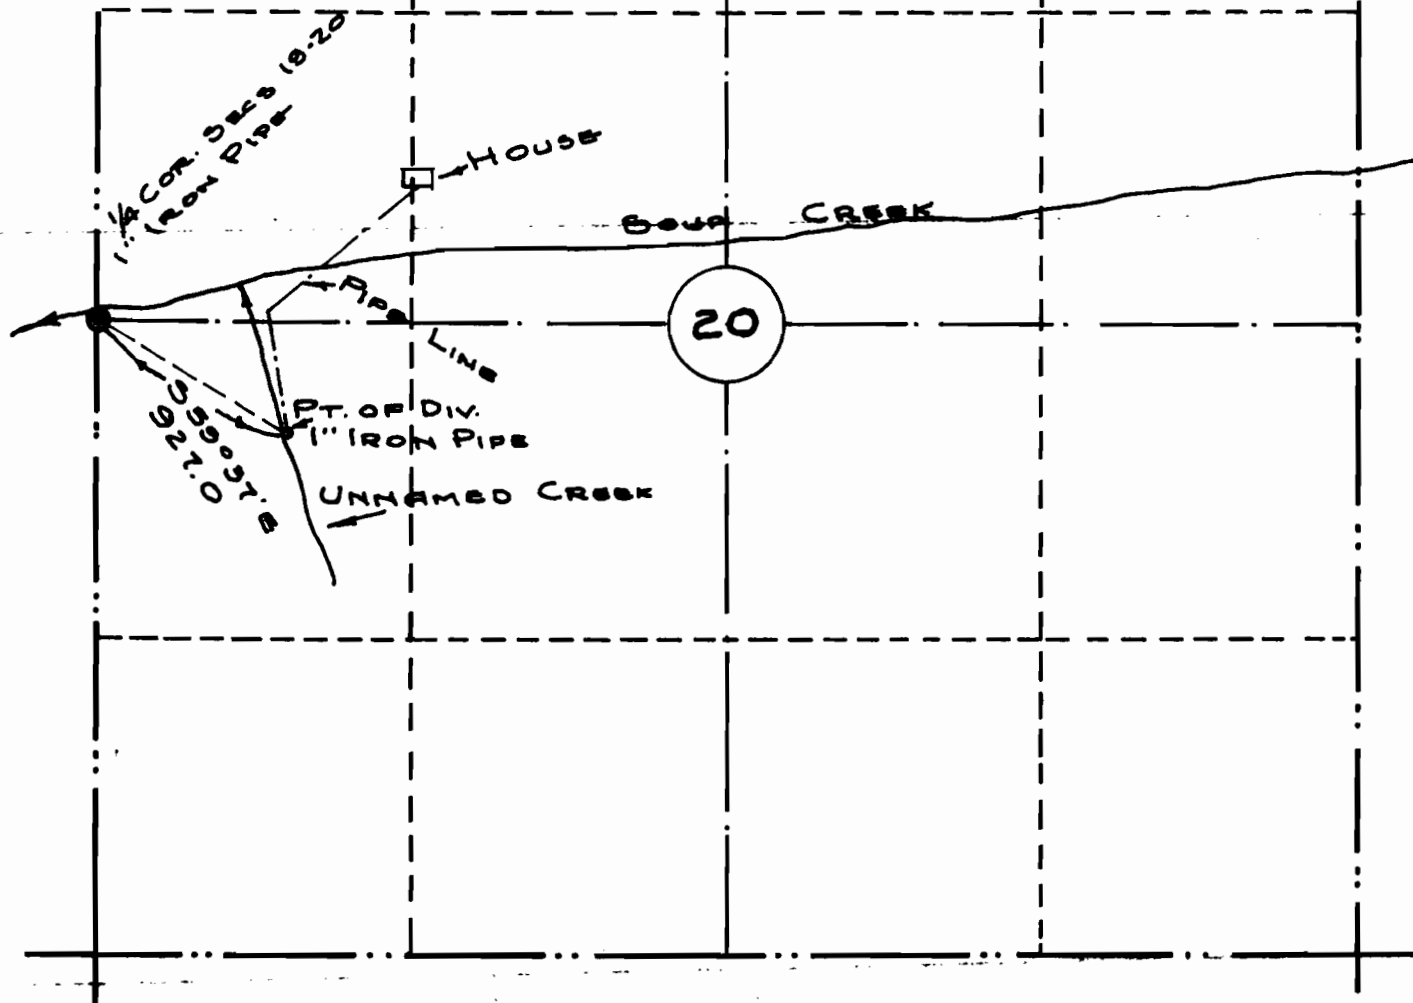

**WATER RIGHT
FOR
ELVIN DEGNATH**

**SECTION 20, T23S, R9W, WM.
A.R. EVANS, ENGINEER
ROSEBURG, OREGON
SCALE 1" = 800'**

App. 28951

Per 22722