


T1N, R4W, WM.

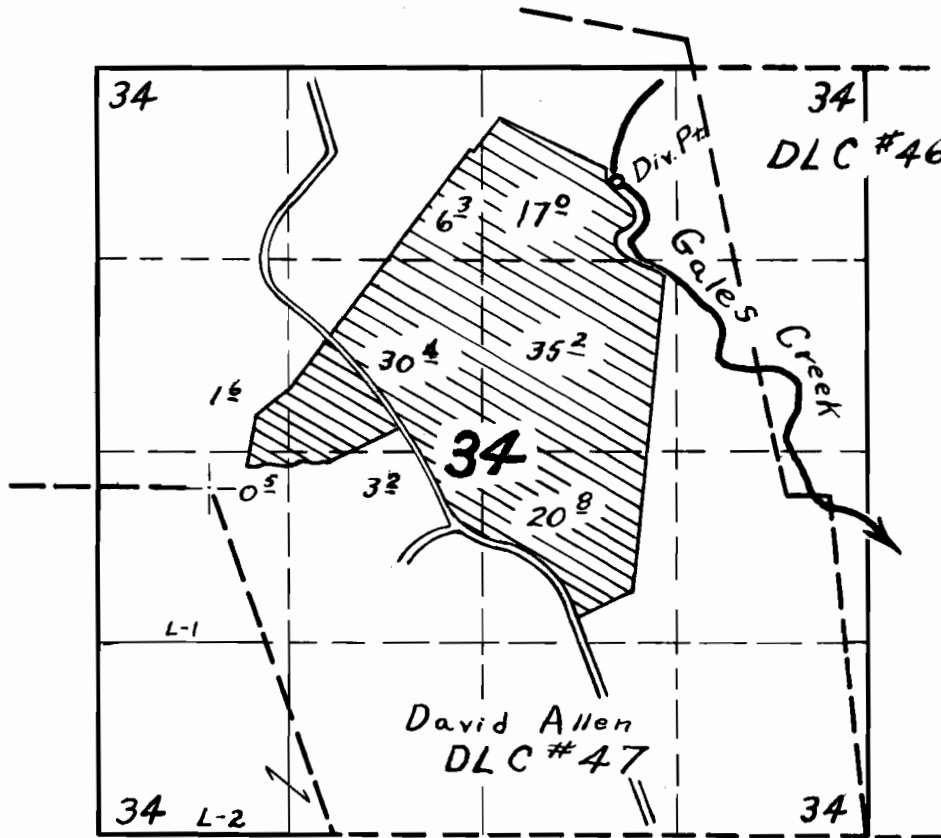

FINAL PROOF SURVEY

UNDER

Application No. 28964 Permit No. 22723

IN NAME OF

Ritchey Bros.

Surveyed 4-10 1956, by RDB est.