


22110
22111
26919
26921

T. 37S. R. 20E. W.M.

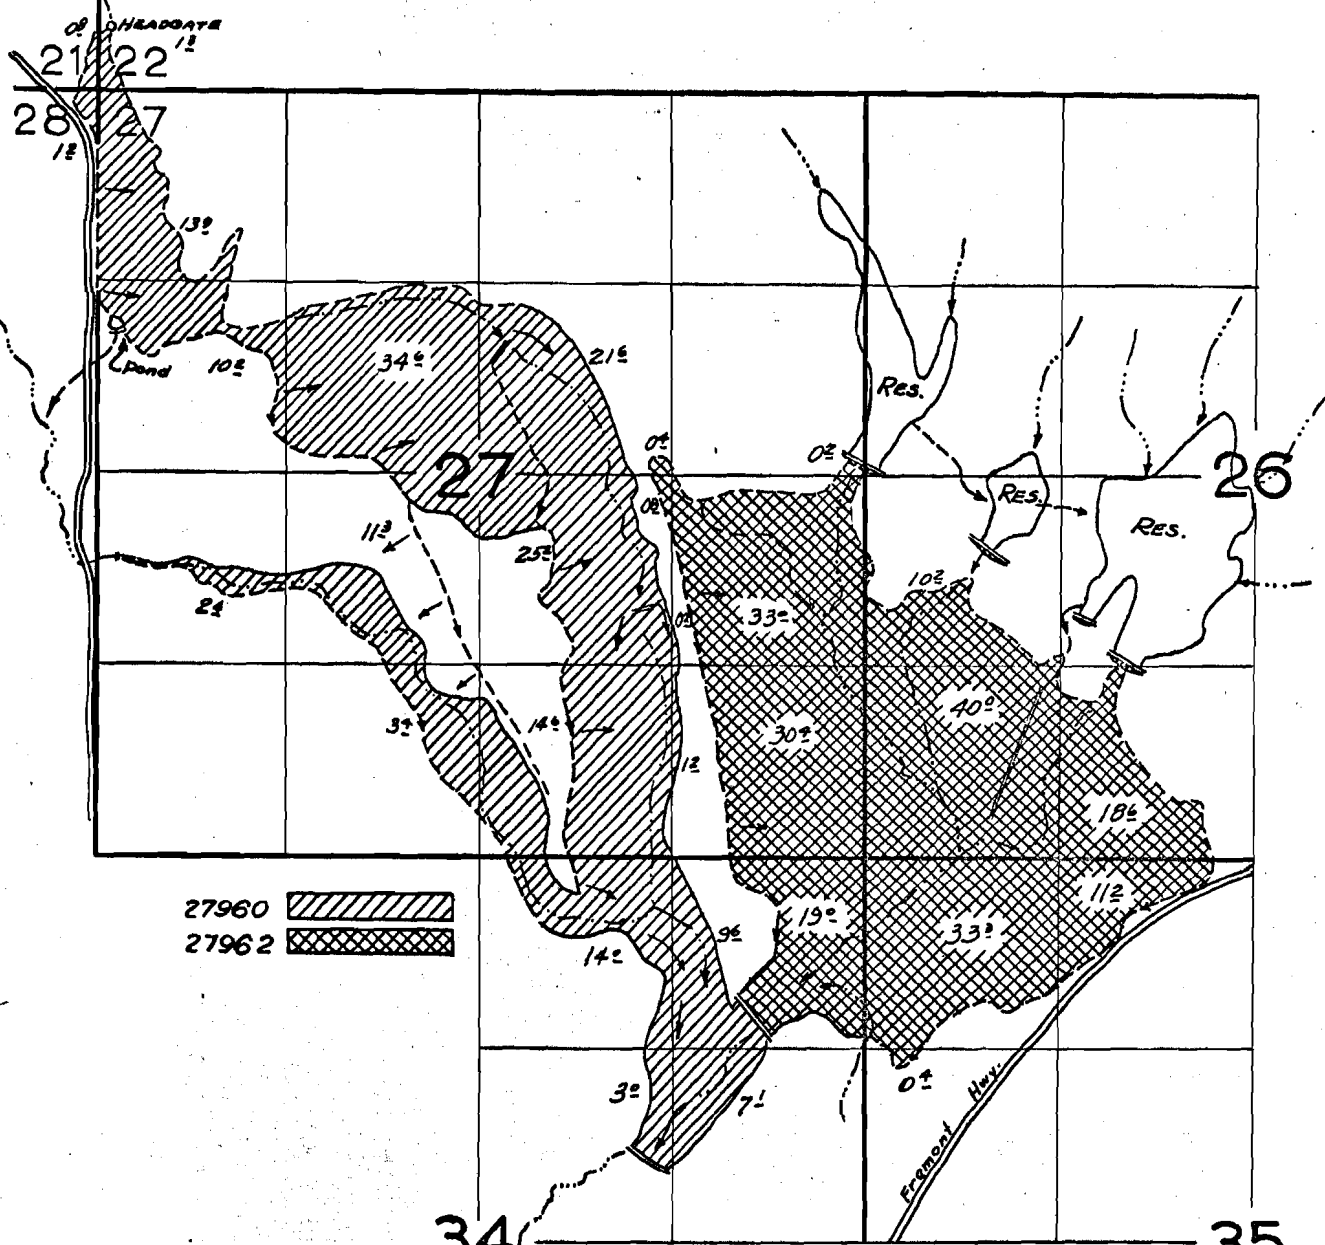

34 FINAL PROOF SURVEY 35 UNDER

27960 22110
R-27961 R-1481
Application No. 27962 Permit No. 22111.....
IN NAME OF

CON TAYLOR

Surveyed May 14, 1959, by R. Jackson

37-20 ✓