


T40S.R43E.W.M.

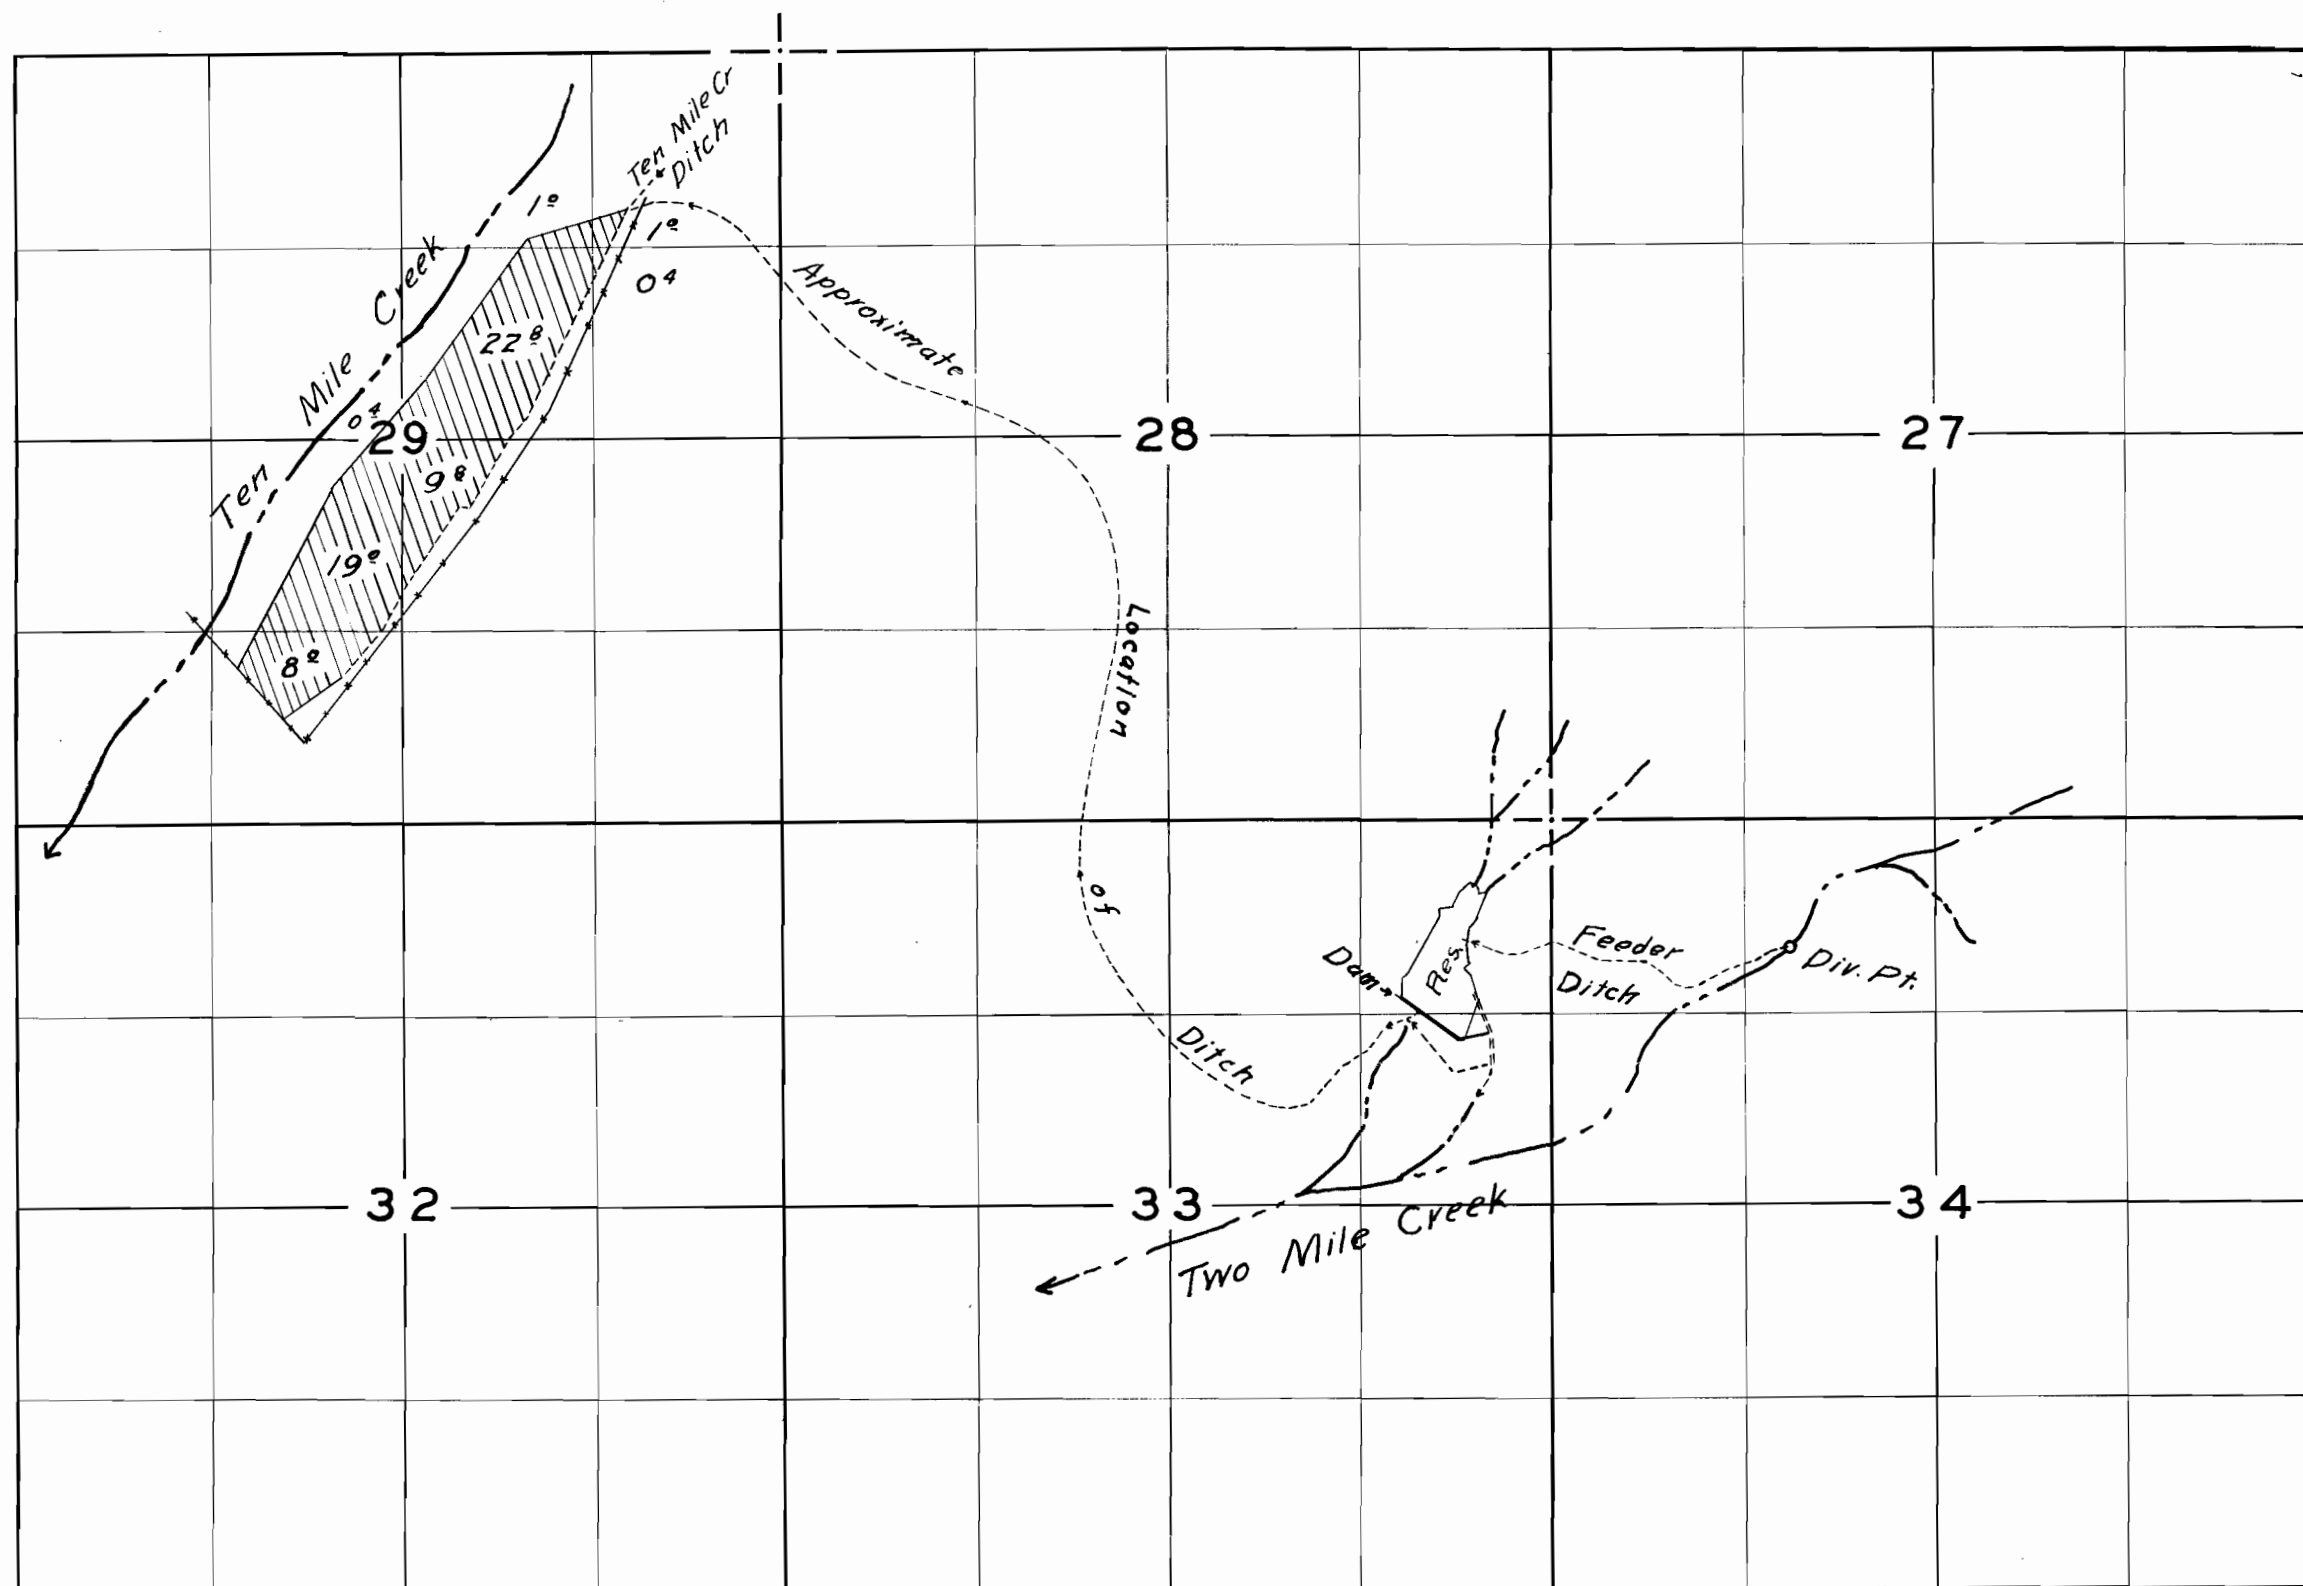

FINAL PROOF SURVEY

UNDER

APPLICATION NOS. R23252 & 23236 PERMIT NOS. R942 & 18349

IN NAME OF

THE ESTATE OF JOE BANKOFIER

SURVEYED 7 NOVEMBER 1955, BY Robert H. Beck