


T.3S.R.3 W.W.M.

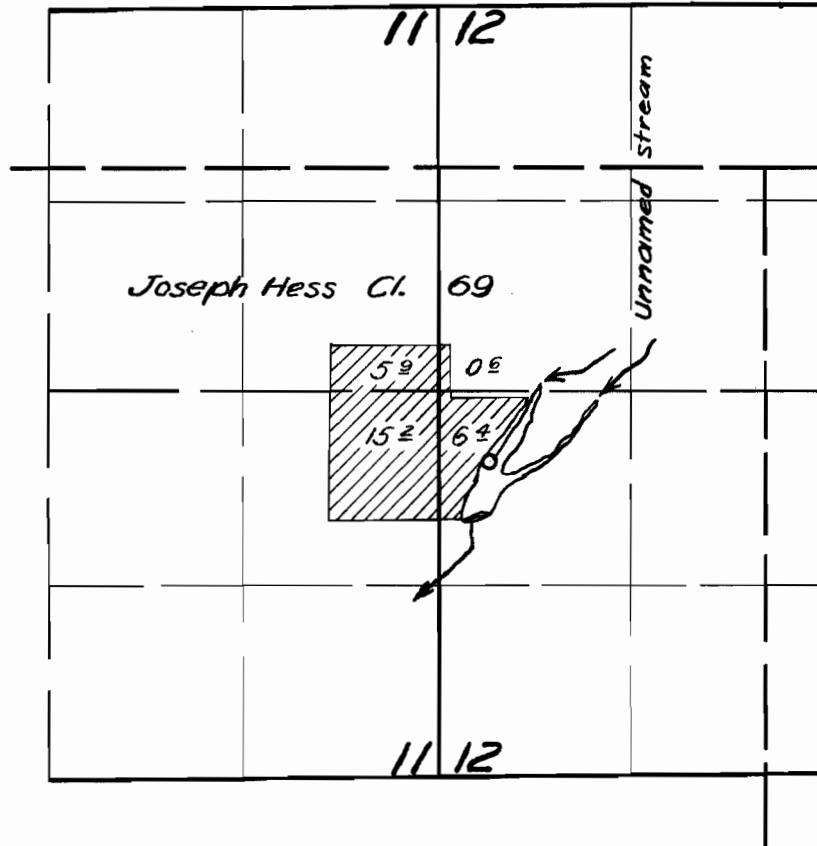

FINAL PROOF SURVEY

UNDER

R-23378

R-958

Application No. 23379 Permit No. 18564

IN NAME OF

The Estate of A. L. Tangen

Surveyed Mar. 20 1956 by M. Bish