


T. 4 S. R. 5 W. W. M.

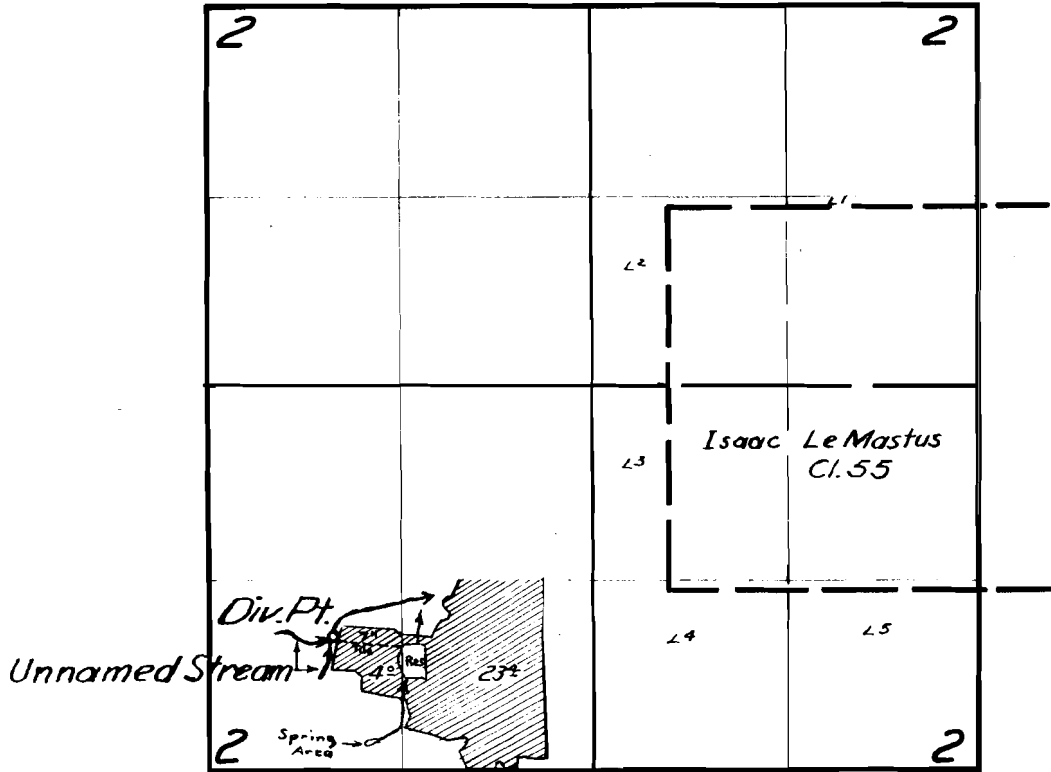

FINAL PROOF SURVEY

UNDER
23915

19427

Application No. P-23914 Permit No. P-1019

IN NAME OF

Chas. G. Smith

Surveyed Mar 13 1956, by Tom. Bish