


T.4S.R.5W.W.M.

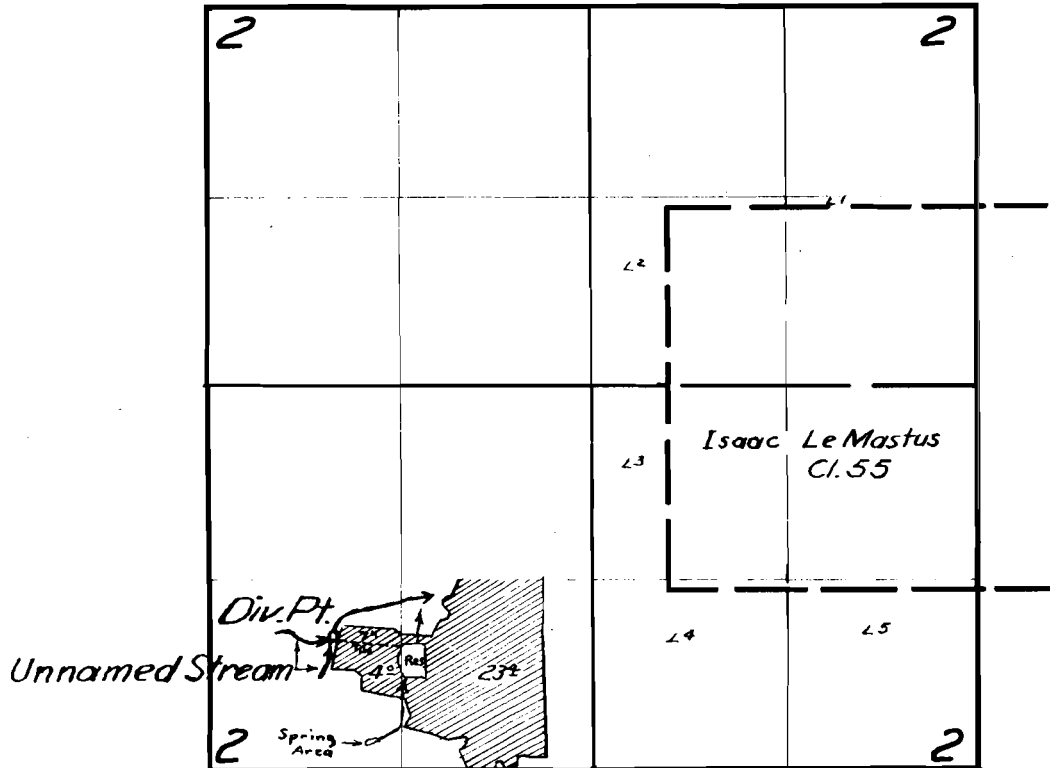

**FINAL PROOF SURVEY**

UNDER

23915

19427

Application No. R-23914 Permit No. R-1019.

IN NAME OF

Chas. G. Smith

Surveyed Mar 13 1956, by M. B. Bish