

6537

M 10

Accompanying plat is to apply, which is for domestic use by


PETER SALTZMAN

In section 8, Twp. 2 N. - R. 11

Scale 1"=800' - 1/4 12, 1915

CERTIFICATE OF SURVY

I, Murray Kay, of Hood River, Or. hereby certify that this map was from notes taken during an act made under my immediate super on the 8th day of October 1915. it correctly represents the work cribed in the accompanying app together with the location of 5th. and other dikes in the immed ity, and has written thereon in each smallest legal sub which it is proposed to in fig.

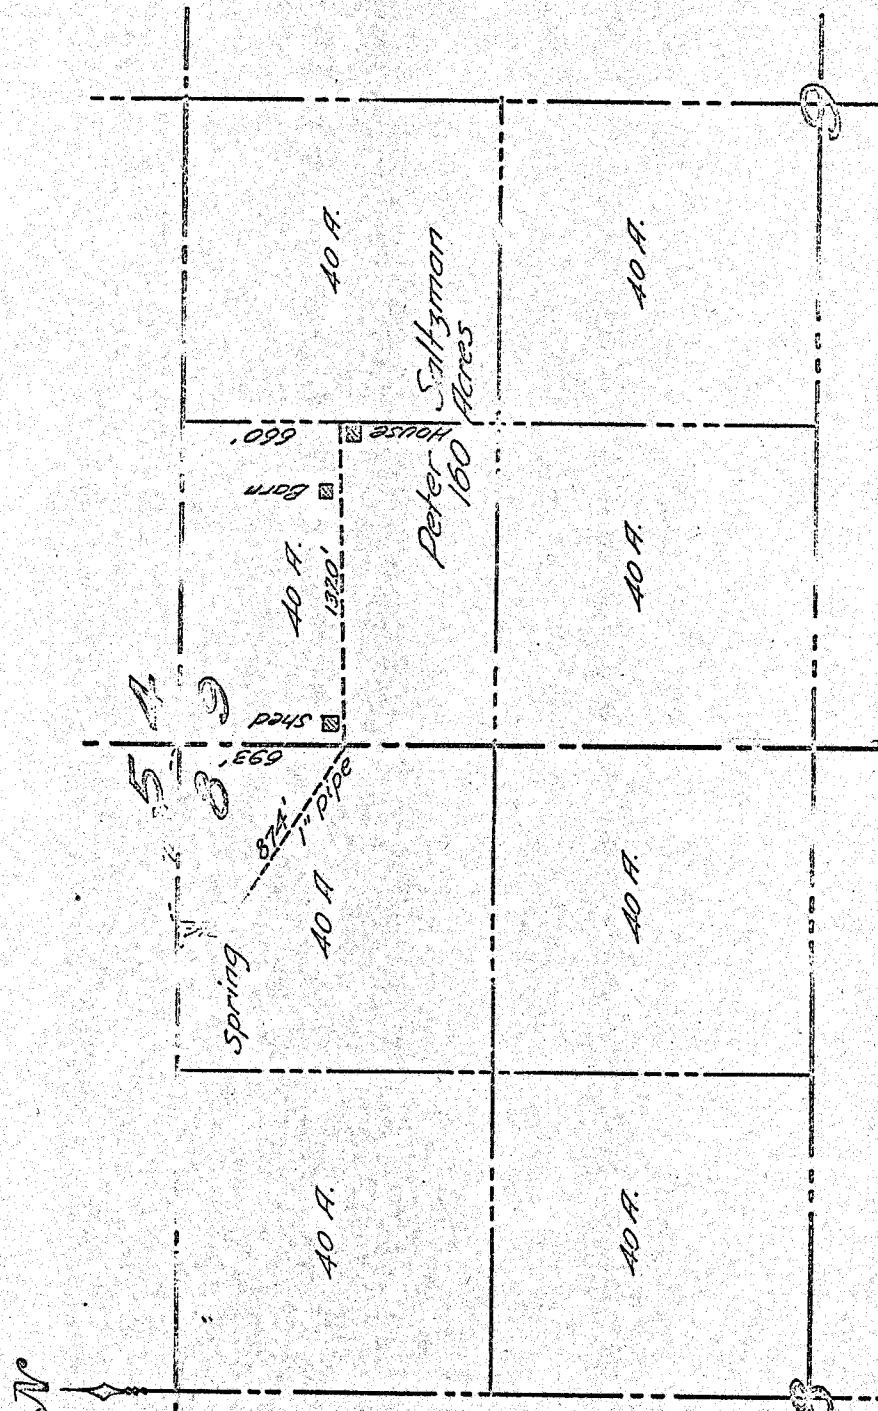

OFFICE OF STATE ENGINEER

RECEIVED

OCT 14 1915

SALEM, - OREGON,

4560

2684

*Murray Kay*

2684