


T. 8 S. R. 1 W. W.M.

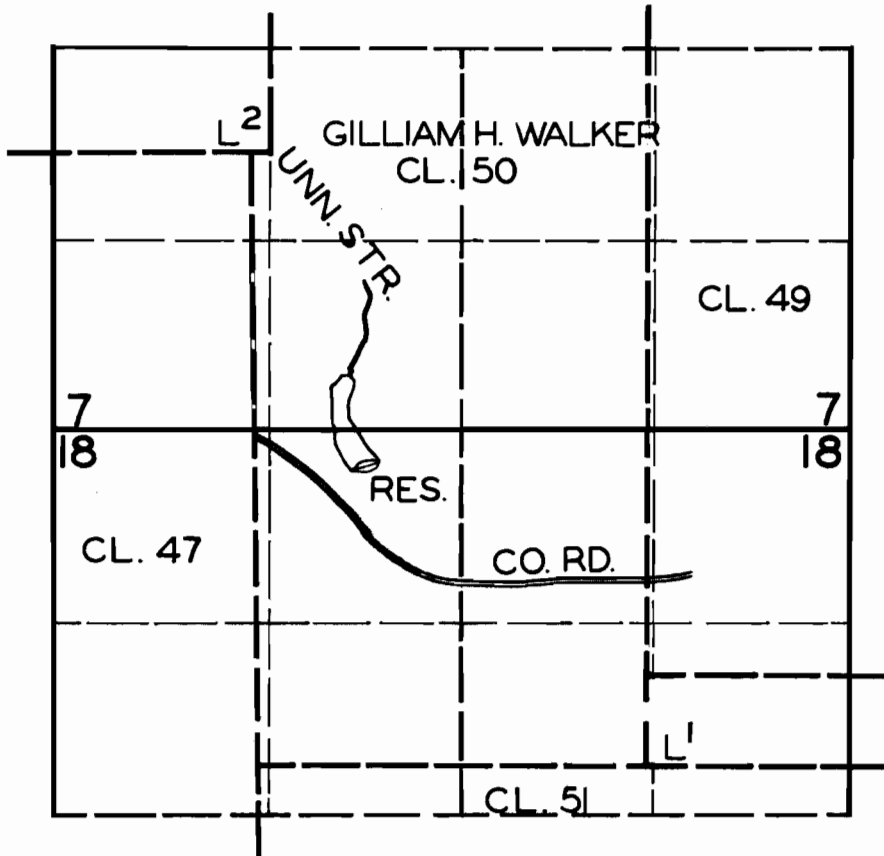

**FINAL PROOF SURVEY**

UNDER

R-24112

R-1245

Application No. 24113 Permit No. 20768

IN NAME OF

IRVIN BARTELS

Surveyed 2 MAR 1956, by M. BISH