


T. 4 S. R. 3 W. W. M.

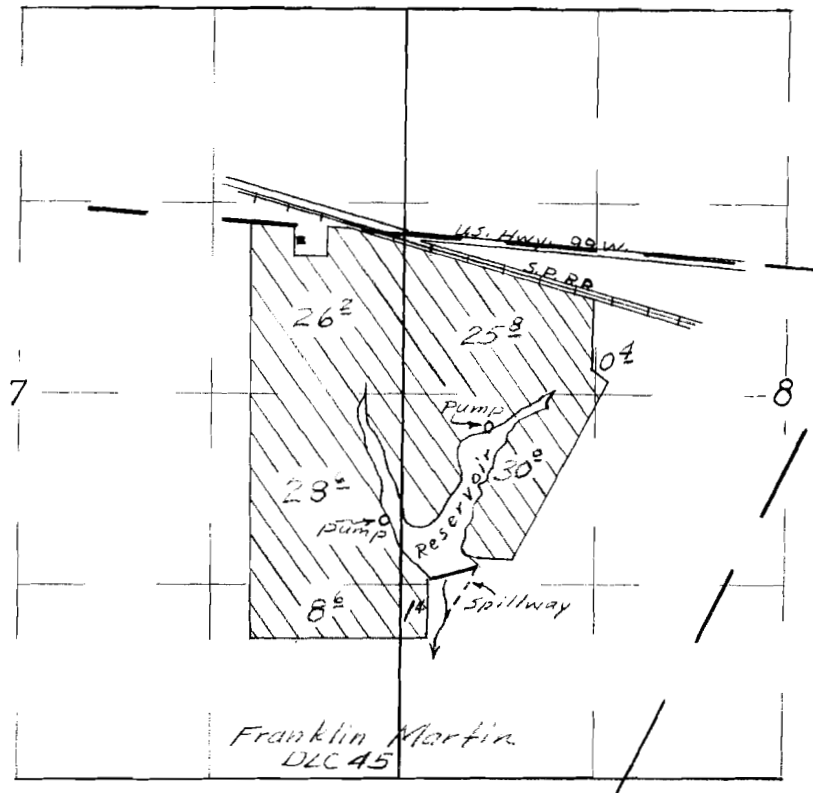

Final Proof Survey
Under

Application No. ^{R-26608} 26609 Permit No. ^{R-1275} 20840
In Name Of

Elsie V. Cole

Surveyed June 6 1955, by T. Jones