


T. 5 & 6 S. R. 7 W. W. M.

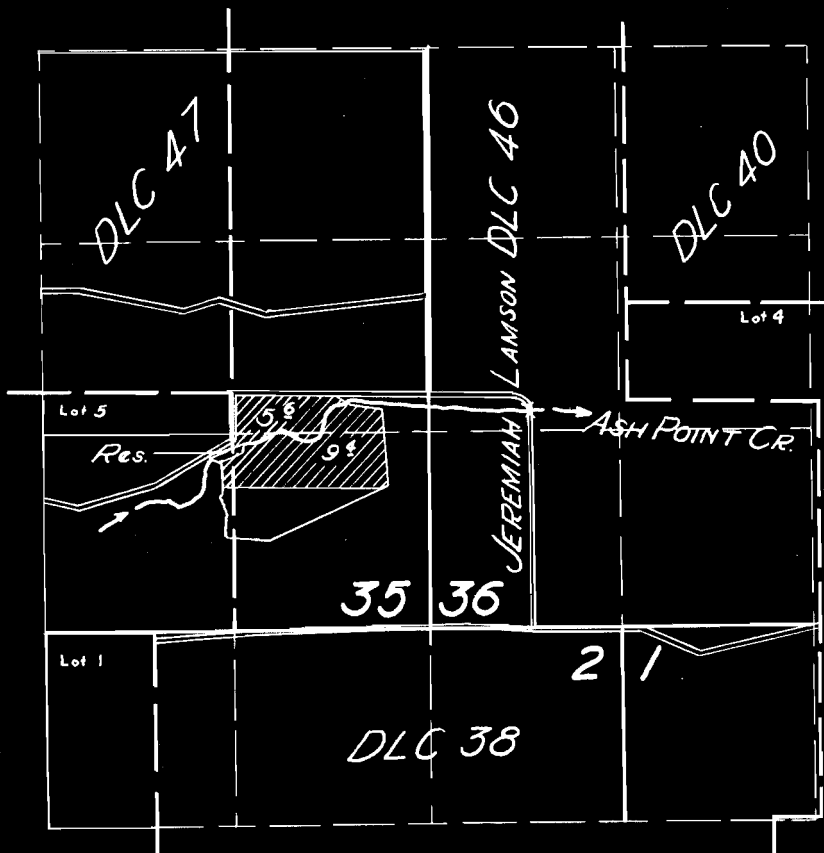

FINAL PROOF SURVEY

UNDER

R-25744

R-1304

Application No. 25745

Permit No. 20975

IN NAME OF

FRED L. BUNN

Surveyed 9 Mar. 1956, by