


T.3 S. R. 2 W.W.M.

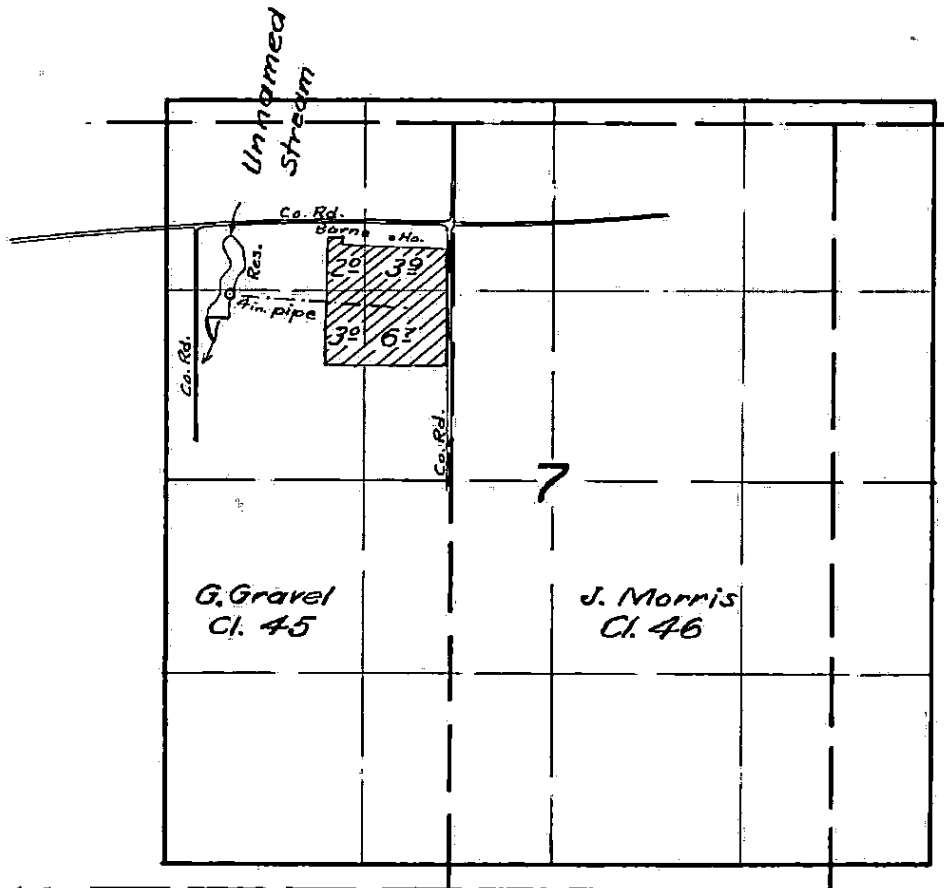

FINAL PROOF SURVEY

UNDER

26055

21244

Application No. R-27328 Permit No. R-1375

IN NAME OF

Fred F. Brunner

Surveyed Mar. 31 1956, by M. A. Bishop