


T.4S.R.4W.W.M.

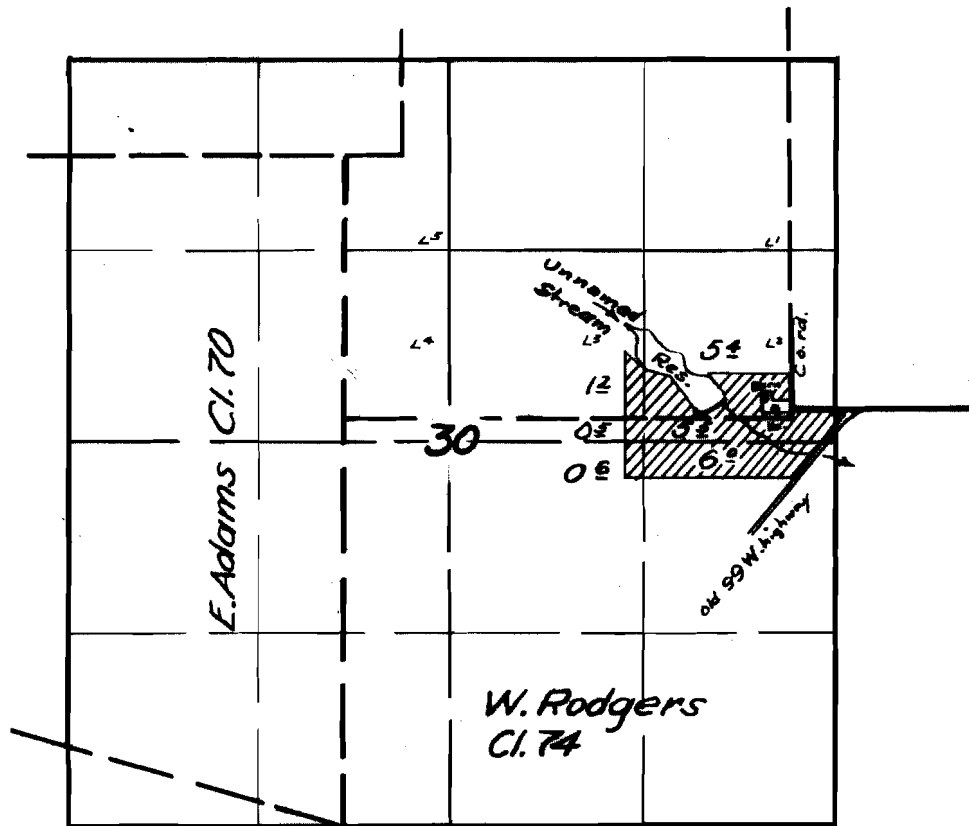

FINAL PROOF SURVEY

UNDER

R-27112

R-1359

Application No. 27349

Permit No. 21402

IN NAME OF

W. L. PEAVEY

Surveyed April 2 1956 by Tom. Beck