


T. 4 S. R. 4 W. W. M.

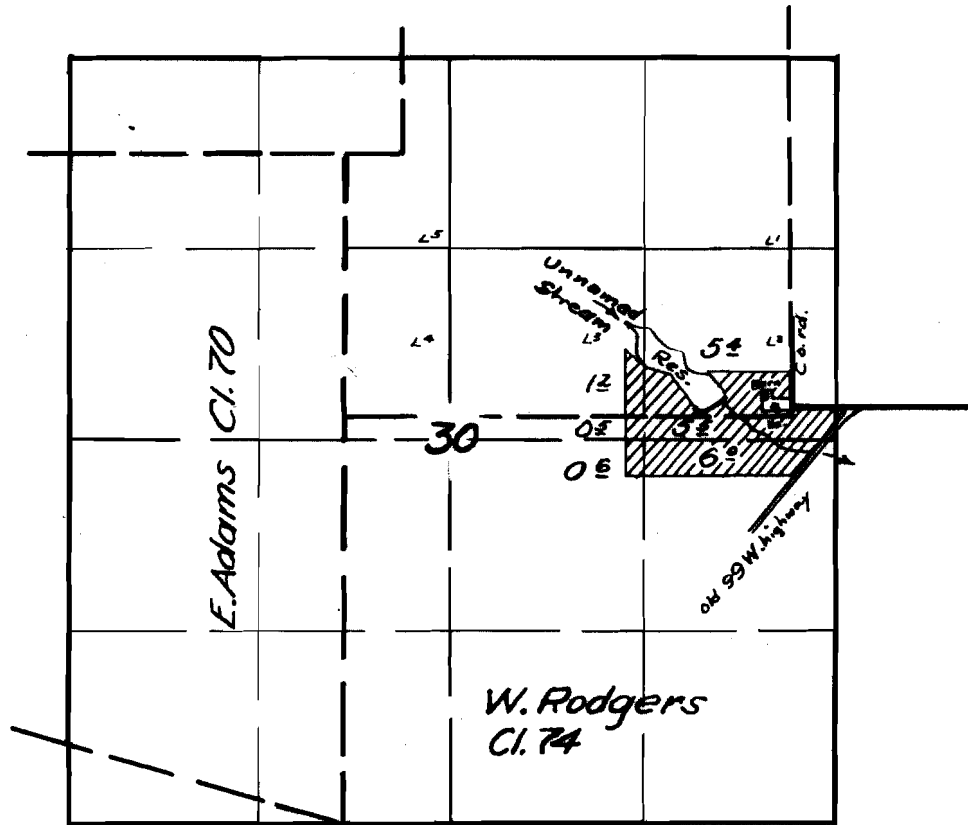

FINAL PROOF SURVEY

UNDER

R-27112

R-1359

Application No. ~~27349~~ Permit No. ~~21402~~

IN NAME OF

W. L. PEAVEY

Surveyed April 2 1956, by Tr. Beh