


T.13S. R.15E. WM.

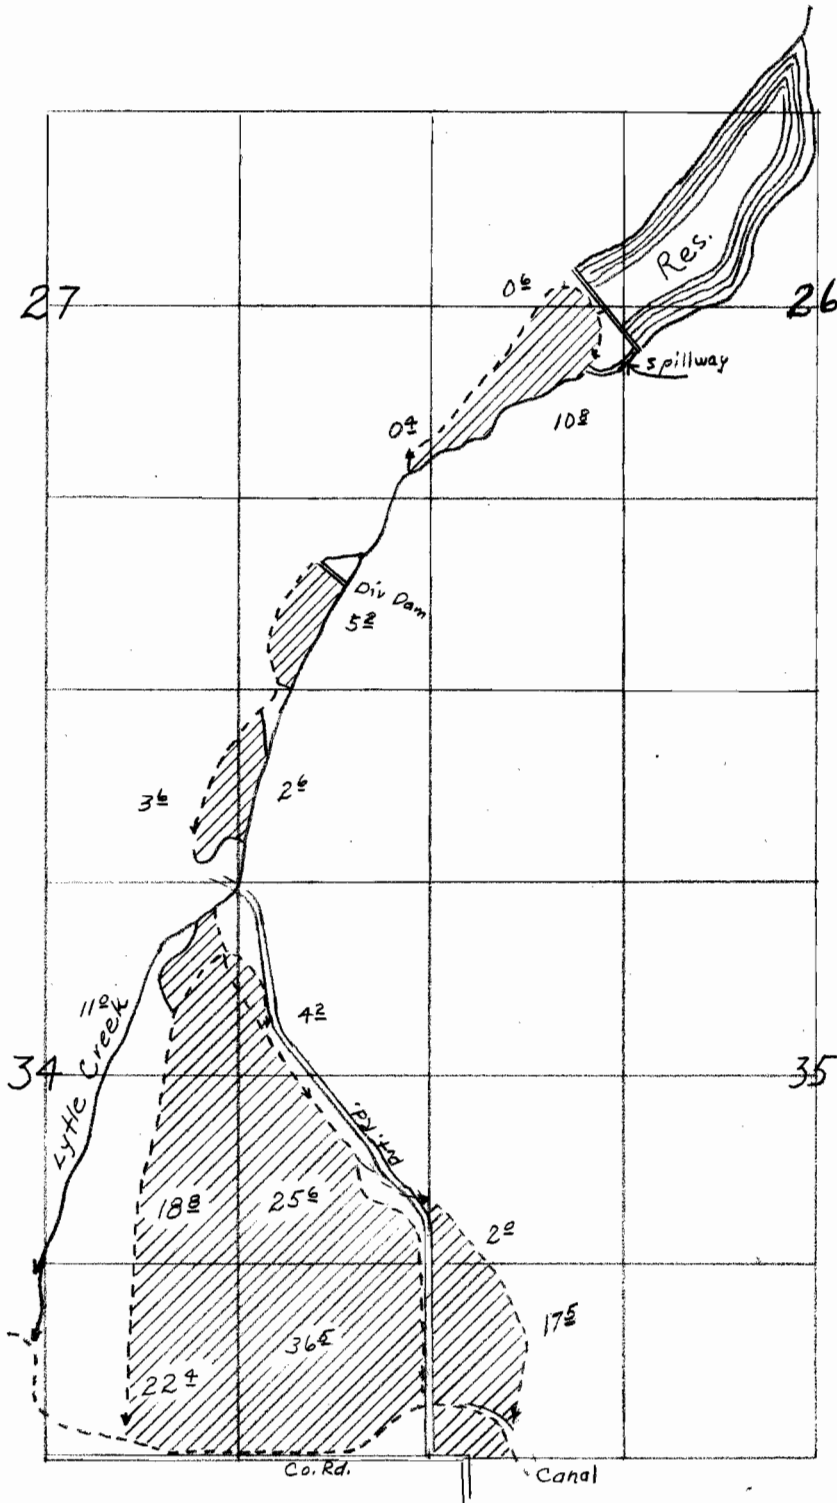

# FINAL PROOF SURVEY

UNDER

Application No. <sup>23521</sup> ~~27901~~ <sup>18636</sup> ~~227200~~ Permit No. <sup>21977</sup> ~~R-1468~~ <sup>R-966</sup>

IN NAME OF

J.O. Fisher

Surveyed Apr 26 1955, by T. Jones