


T. 6S. R. 1E. W.M.

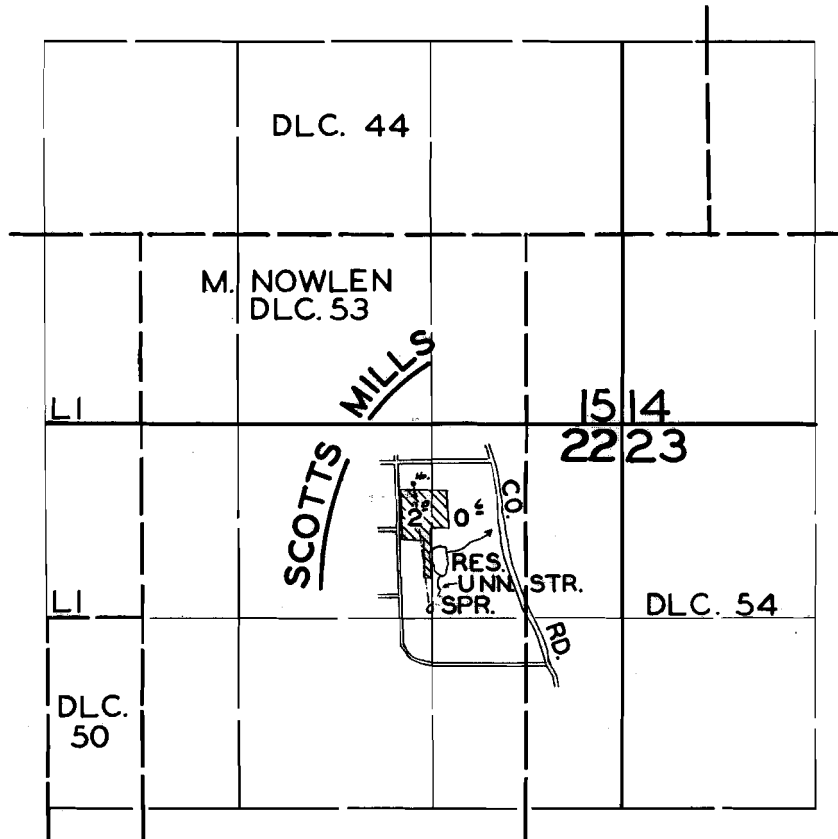

COPY

FINAL PROOF SURVEY

UNDER

R27713

R-1535

Application No. 27714 Permit No. 22481

IN NAME OF

ART & GOLDIE BOYTS

Surveyed 8 AUG. 1956, by M. BISH