


T. 7 S. R. 1 W. W.M.

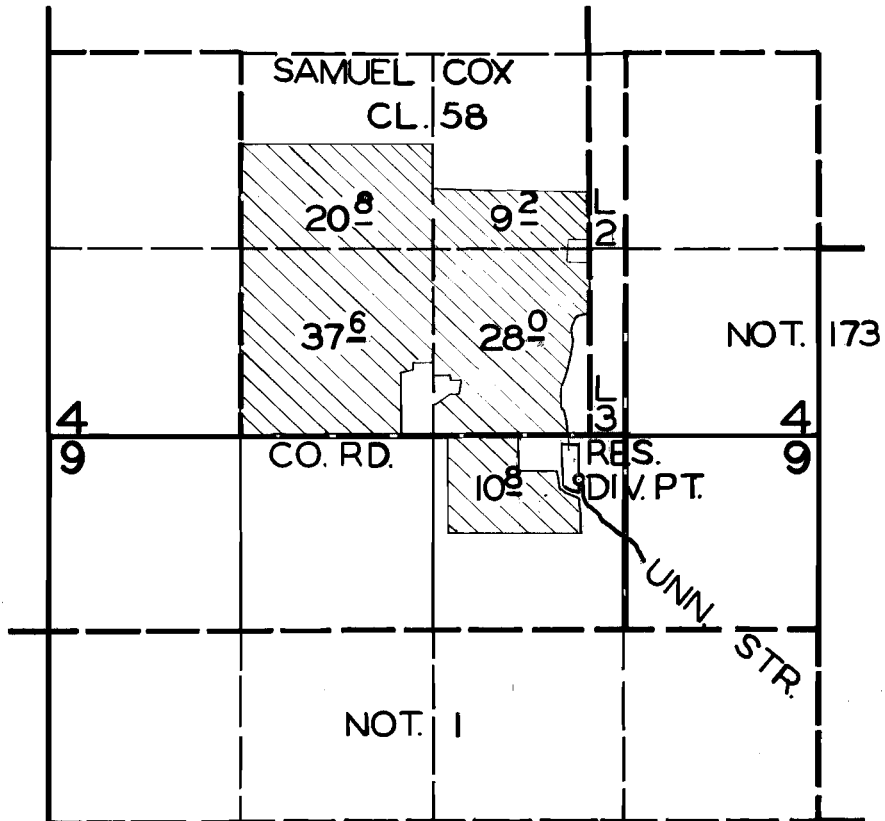

FINAL PROOF SURVEY

UNDER

R-21334

R-831

Application No. 21227 Permit No. 16764

IN NAME OF

HARVEY E. GEHRING

Surveyed 29 FEB. 1956, by M. BISH