


T.27S. R.6W.W.M.

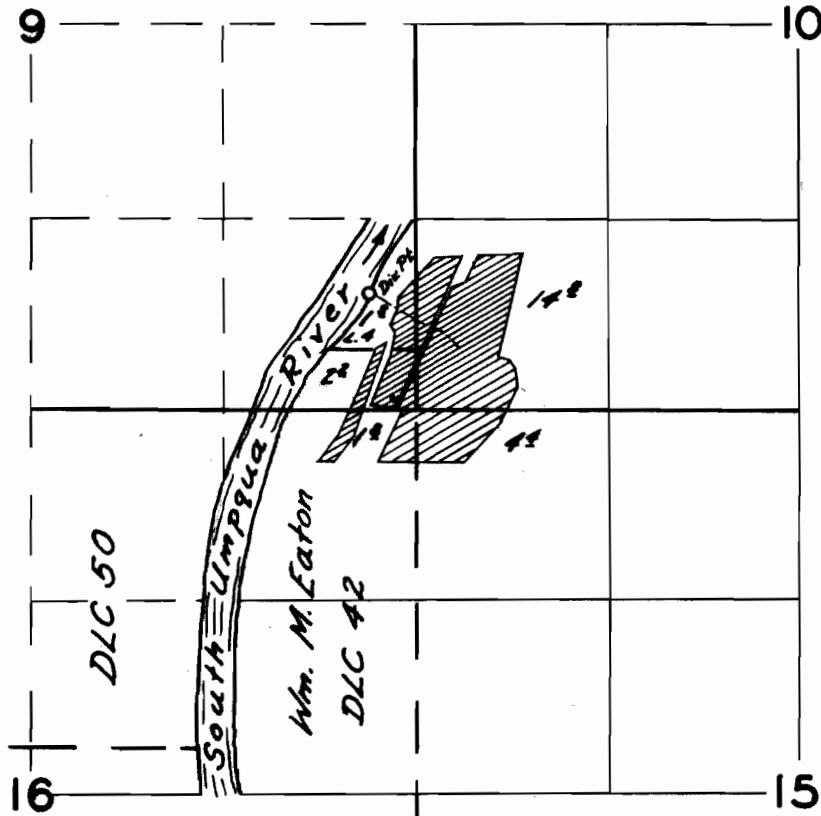

**FINAL PROOF SURVEY**

UNDER

Application No. *17559* Permit No. *13132*

IN NAME OF

*Ben F. Jones*

*R. A. Hastings & Oscar N. Redenko*

Surveyed *Aug. 10, 1956*, by *C. O. Bartels*