


T. 4 S. R. 4 W. W. M.

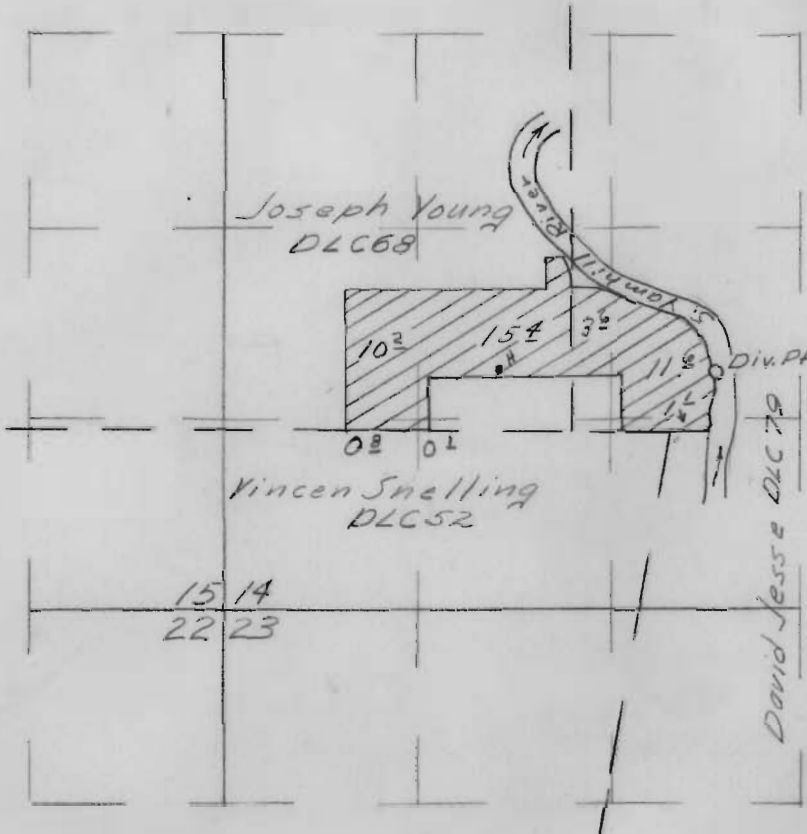

Final Proof Survey
Under

Application No. 17852 Permit No. 13535
In Name Of

Carl Howard

surveyed June 9, 1955 by T. Jones