


T. 4 S. R. 4 & 5 W. W. M.

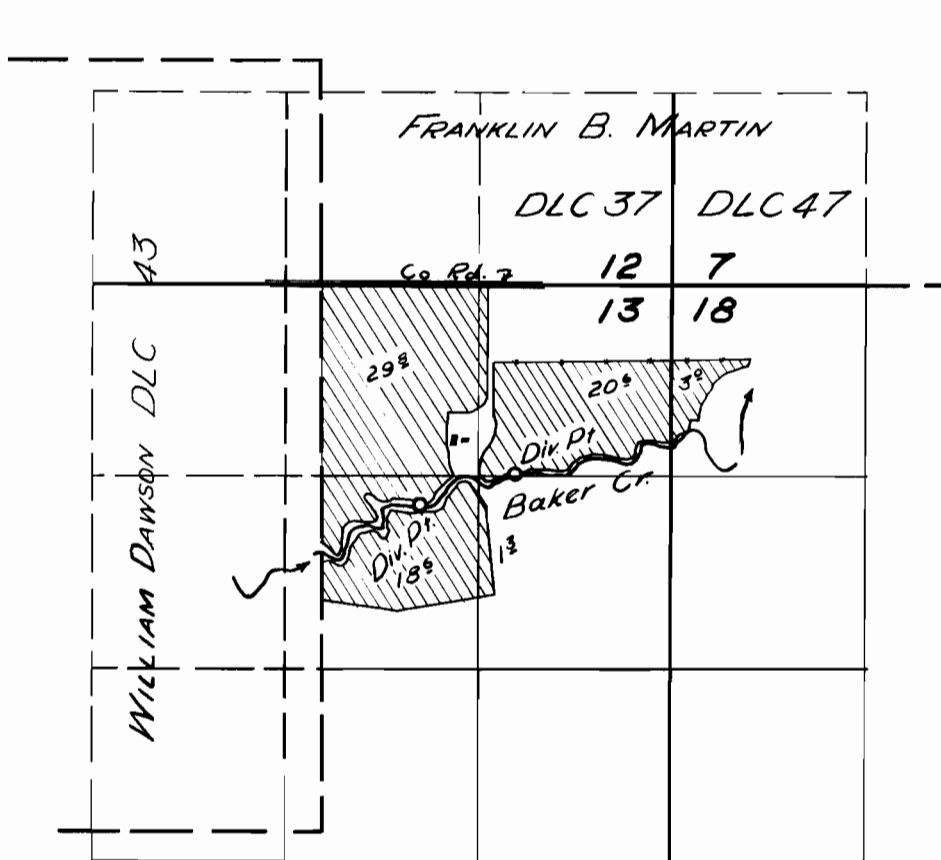

FINAL PROOF SURVEY
UNDER

Application No. 18644 Permit No. 14279
IN NAME OF

DR. J. G. MANNING

Surveyed 7 Mar. 1956, by R. H. Whitby