


T. 6 S. R. 1 E. W.M.

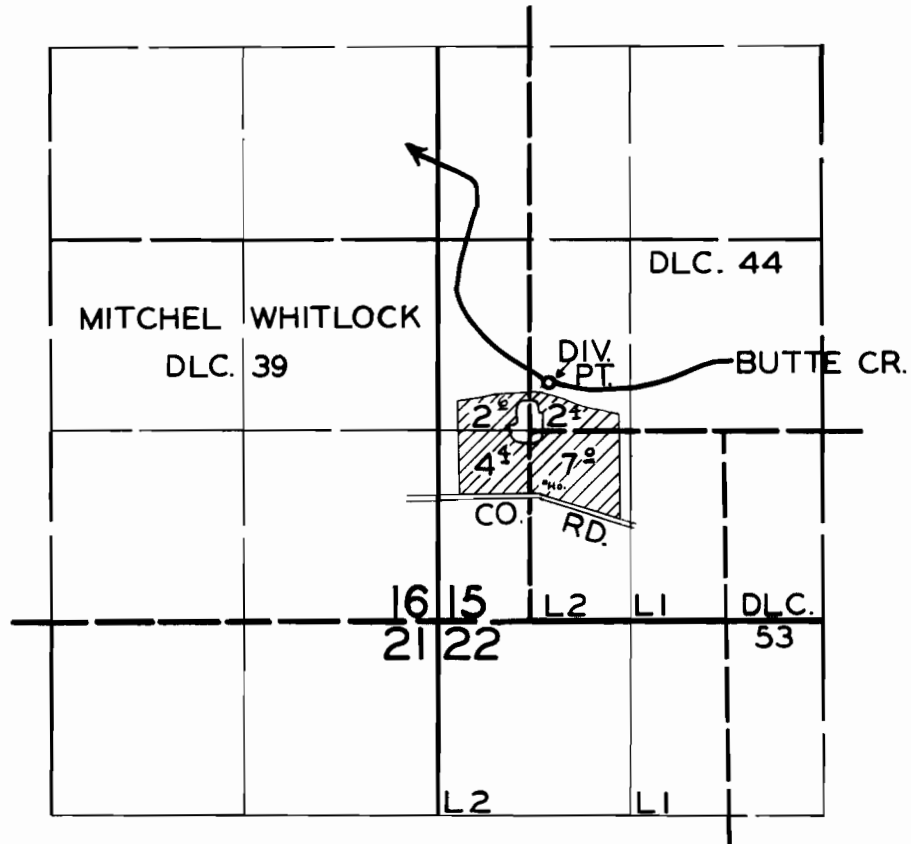

FINAL PROOF SURVEY
UNDER

Application No. 19001 Permit No. 15309
IN NAME OF

CARL E. MILLARD

Surveyed 18 JULY 1956, by M. BISH

Handwritten mark