


T.4N.R.28E.W.M.

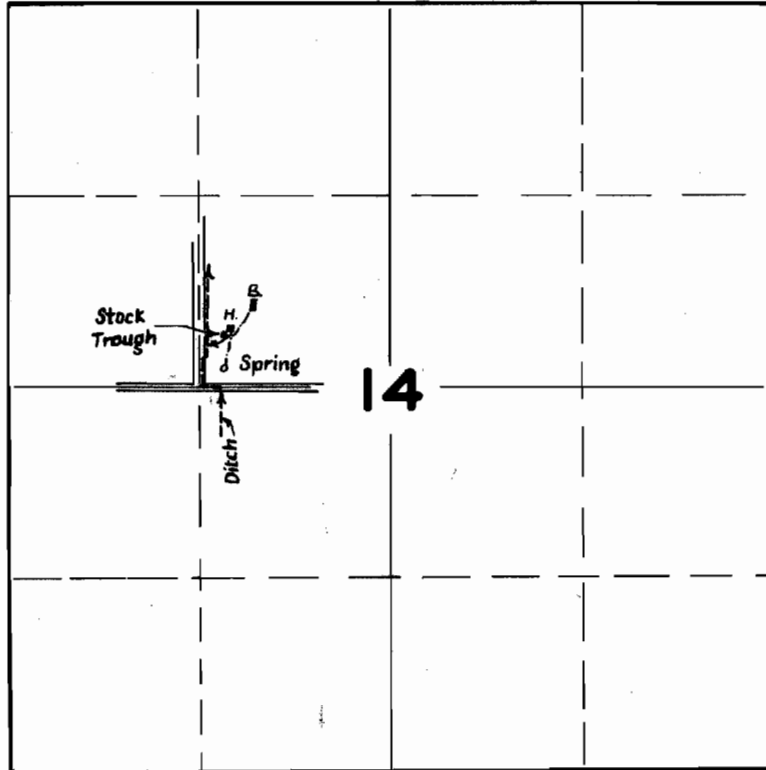

FINAL PROOF SURVEY

UNDER

Application No. 20788. Permit No. 16268
IN NAME OF

JOHN E. & ALLETA J. SHRODER

Surveyed OCT. 6. 1950., by H.L. COFFMAN