


T. 4 S. R. 10 W. W. M.

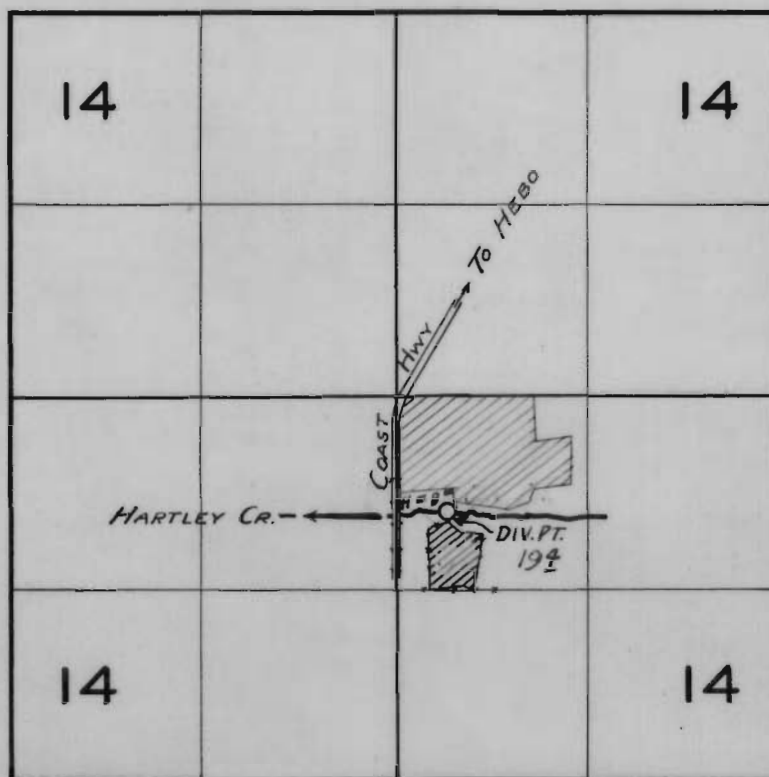

FINAL PROOF SURVEY
UNDER

Application No. 20854 Permit No. 16334
IN NAME OF
HENRY GANN

Surveyed 24 Aug. 1955, by *E. A. Whiteley*