


T29S R12WWM

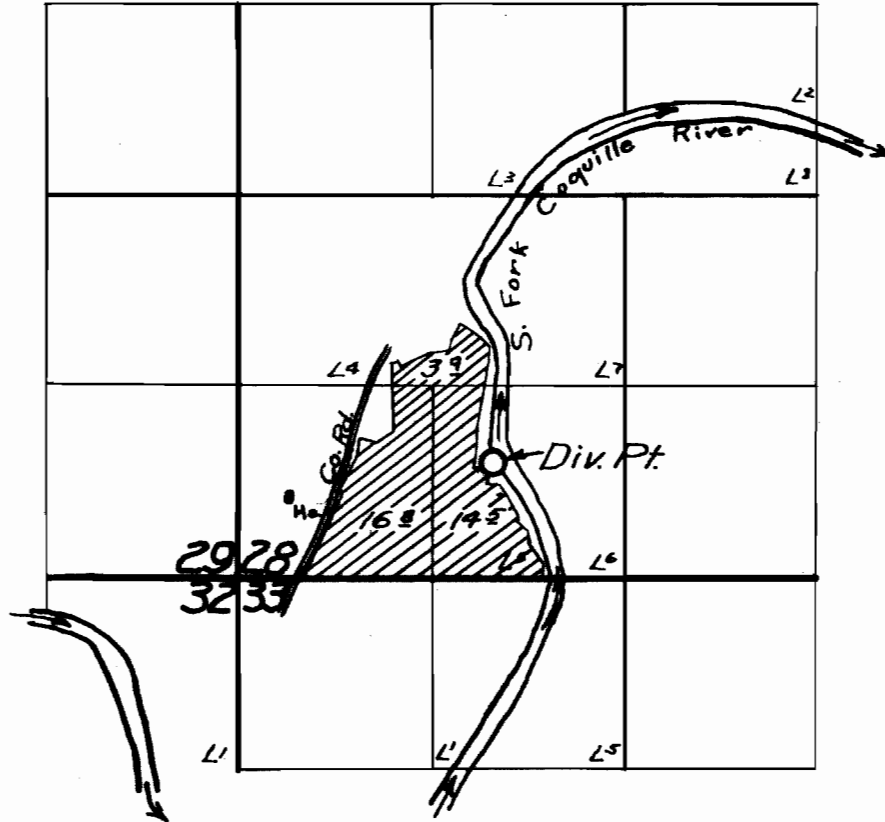

**FINAL PROOF SURVEY**

UNDER

Application No. 21224 Permit No. 16636

IN NAME OF

Thor A. & Romona G. Jamsgard

Surveyed Aug. 10th 1955, by M. Bick