



16776
22159

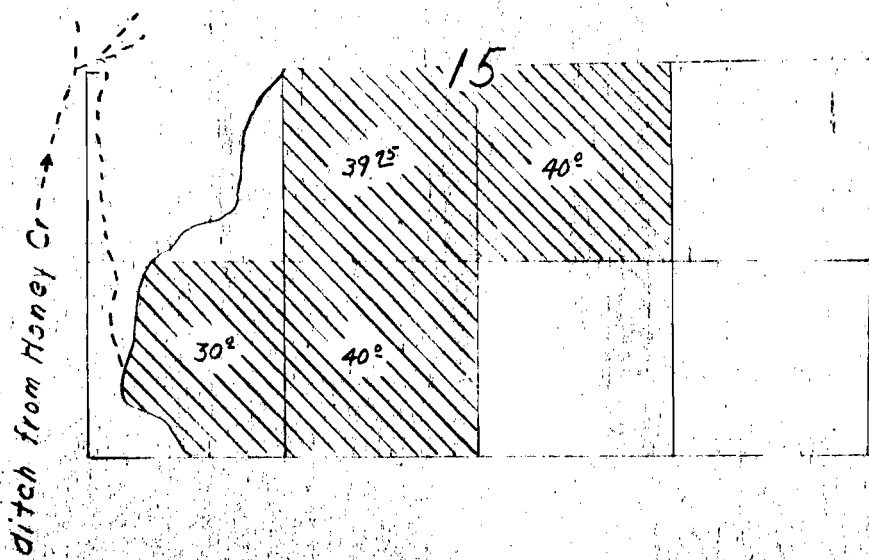

T. 36S. R. 24E. WM

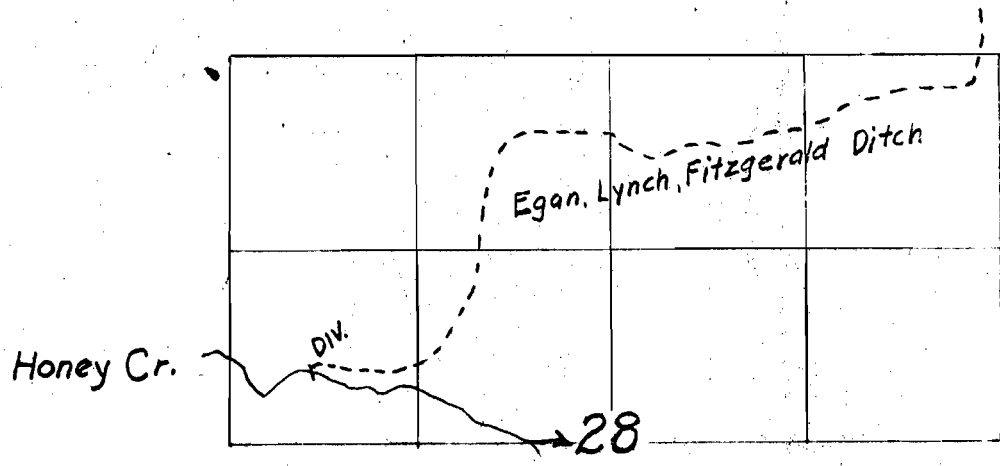

FINAL PROOF SURVEY

UNDER

Application No. 21408 Permit No. 16776

IN NAME OF

Donald J. & Cornelius J. Fitzgerald

Surveyed 6-14 1955, by T. Jones

36-24 ✓