


T. 17S. R. 20E. W.M.

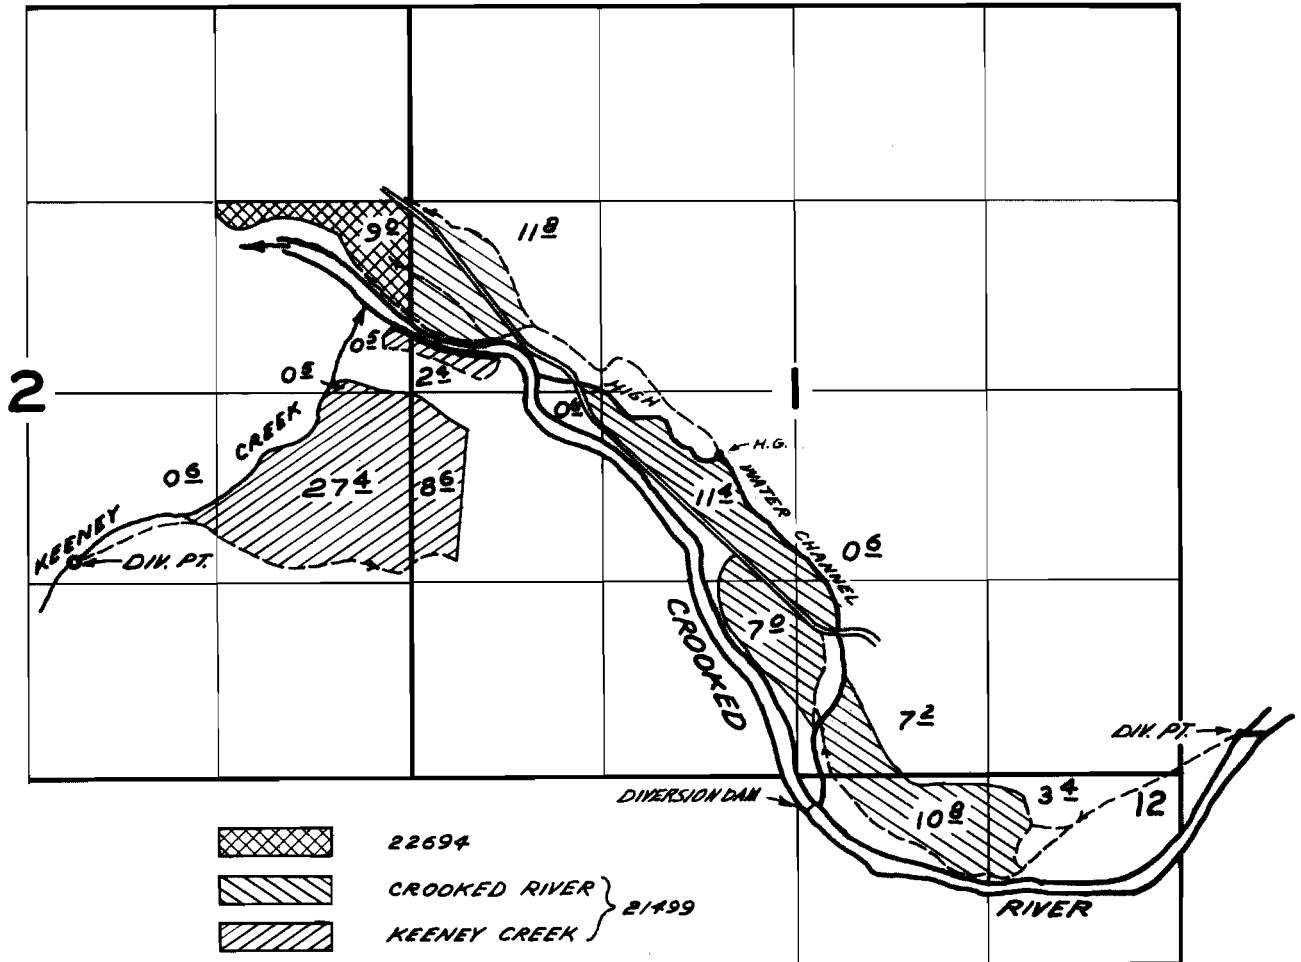

FINAL PROOF SURVEY UNDER

Application No. 21499 22694 Permit No. 16862 17845
IN NAME OF

F. S. McCULLOUGH

Surveyed APR. 25 1955, by T. JONES