


T. 5 S. R. 7 W. W.M.

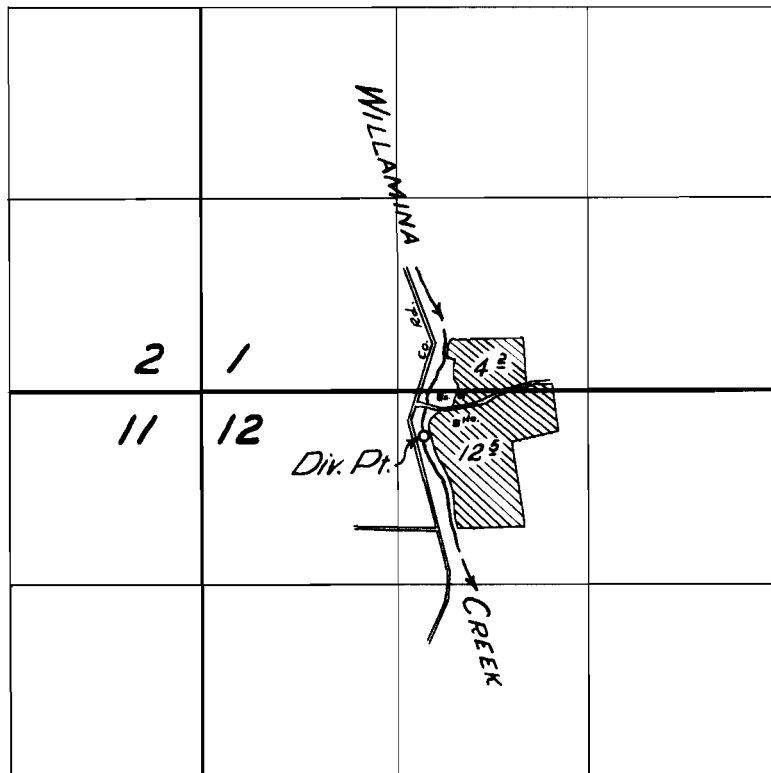

FINAL PROOF SURVEY

UNDER

Application No. 21770 Permit No. 17126

IN NAME OF

PAUL KOM

Surveyed 12 Mar 1956, by *[Signature]*