


T. 4 S. R. 7 W. W. M.

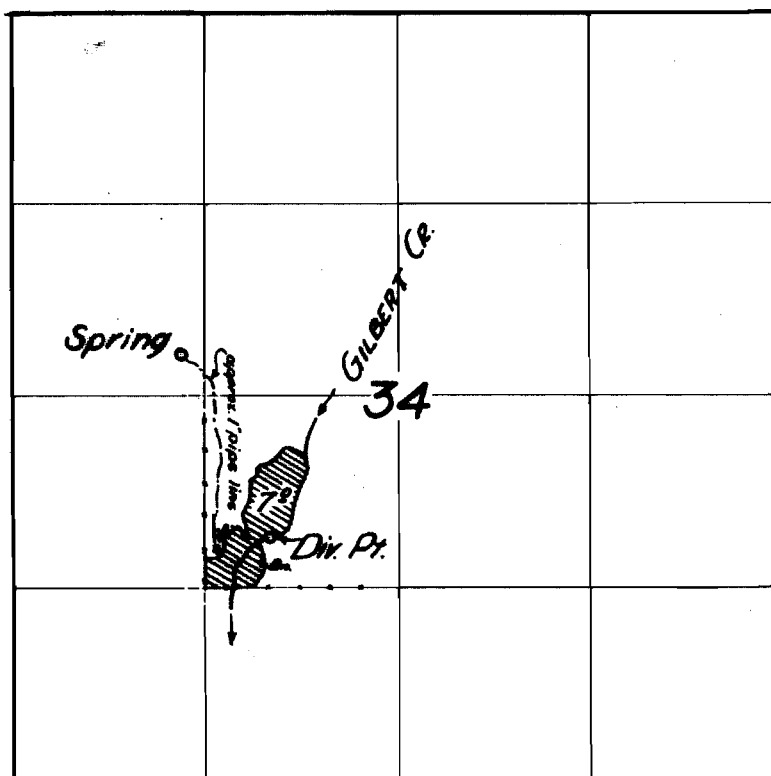

FINAL PROOF SURVEY
UNDER

Application No. 21940 Permit No. 17317
IN NAME OF

E. H. MITCHELL

Surveyed 12 Mar. 1956 by C. A. Hickey