


T. 4 S. R. 5 W. W. M.

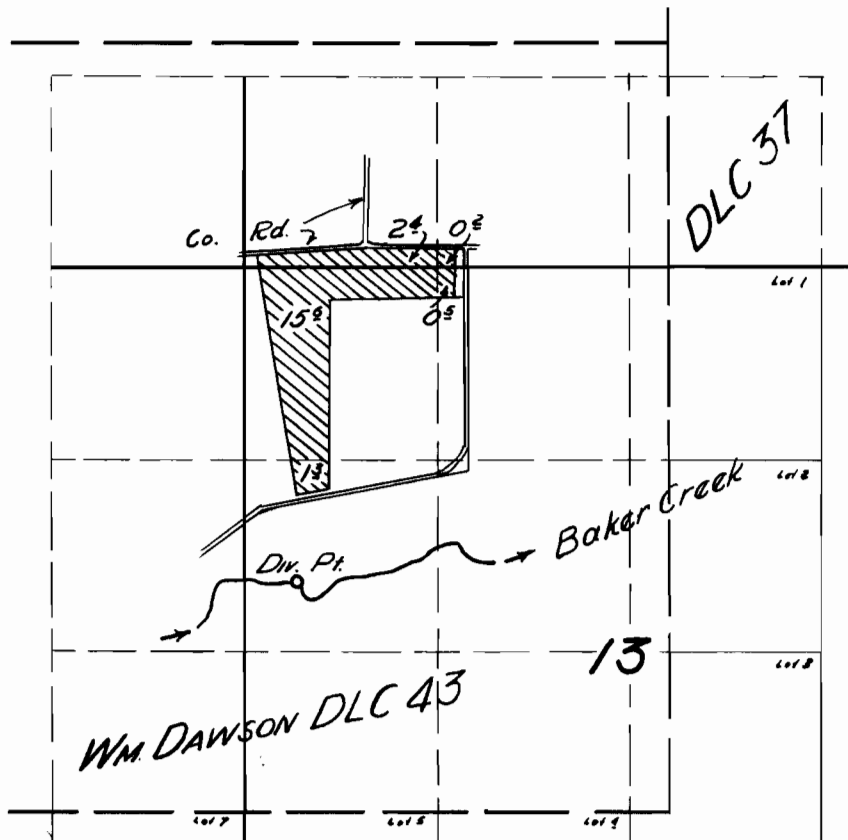

FINAL PROOF SURVEY

UNDER

Application No. 22351 Permit No. 17622

IN NAME OF

WILLIAM & BERNARD TURLEY

Surveyed 22 Sep. 1955, by [Signature]