


T. 7S. R. 3W. W.M.

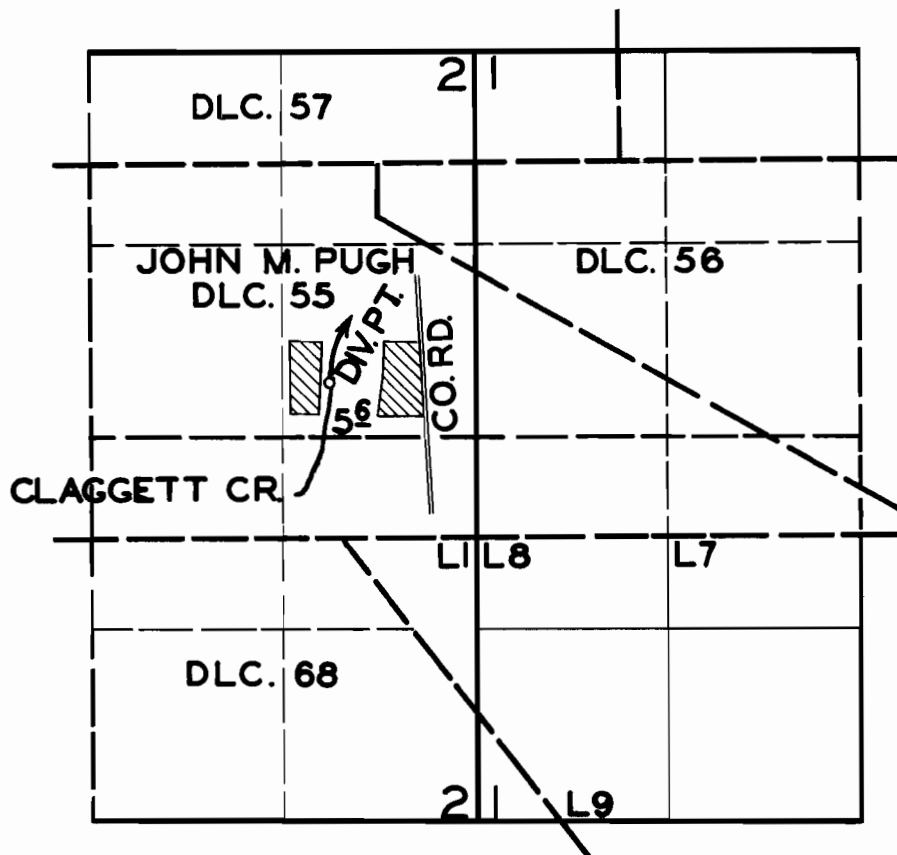

FINAL PROOF SURVEY

UNDER

Application No. 22500 Permit No. 17737

IN NAME OF

RUBEN WARGNIER

Surveyed 2 MAR. 1956, by M. BISH