


T. 17S. R. 20E. W.M.

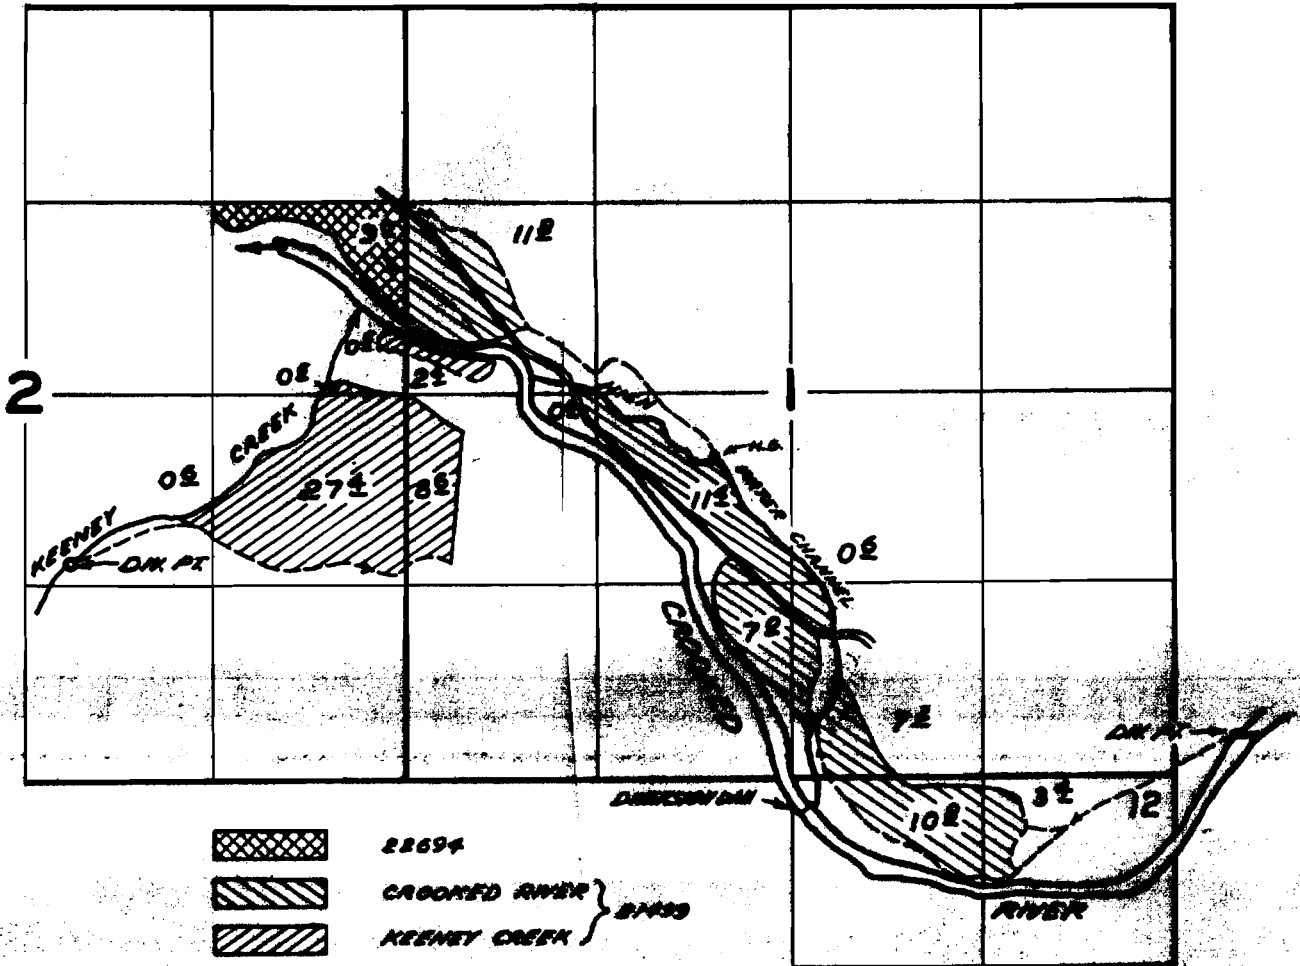

FINAL PROOF SURVEY UNDER

Application No. ²¹⁴³⁹~~22694~~ Permit No. ¹⁸⁰⁶²~~17075~~
IN NAME OF

F. S. McCULLOUGH

Surveyed APR. 25 1955, by T. Jones