


T. 5 S. R. 6 W. W.M.

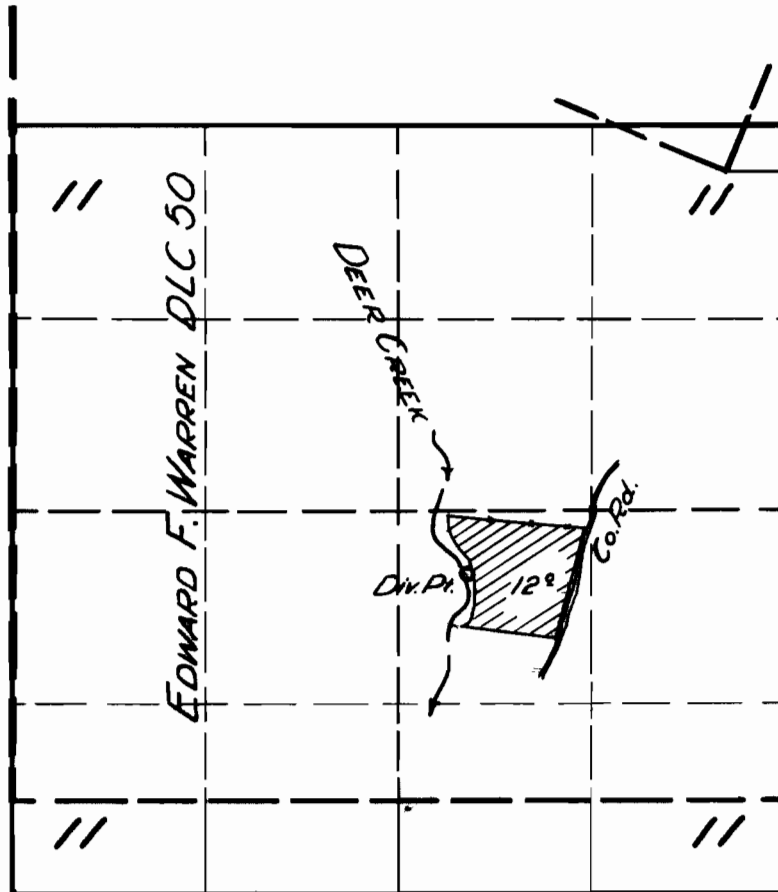

**FINAL PROOF SURVEY**

UNDER

Application No. 23172 Permit No. 18250

IN NAME OF

WILFRED SMITH

Surveyed 8 Mar. 1956, by R.H. Whitby